IREDELL COUNTY HEALTH DEPARTMENT

STATESVILLE 704-878-5305 315.00 Paid MOORESVILLE 704-664-5281

IMPROVEMENT PERMIT / AUTHORIZATION TO CONSTRUCT / OPERATION PERMIT / EXISTING SYSTEM INSPECTION

PERMIT# 117175 PIN# 4636 30 1527 DATE 1/9/04

OWNER OR CONTRACTOR Flagship Builders LLC PHONE: Business 980-721-1249 Home

ADDRESS PO Box 4568 Mooresville, NC. 28117

LOCATION Isle of Pines, 1100 TL Isle Pines 3RD Rot on (L) just Jamnett Rd. 480 AWS

SUBDIVISION Hoy Ridge BLOCK / SECTION LOT 3 LOT AREA 1.10 Ac SITE CLASS. PS DESIGN FLOW ~~360~~ L.T.A.R. .3

Septic Tank: 1000 Gallons; STB 312 Date 5/19/04

Pump Tank: 1000 Gallons; PT 783 Date 6/16/04

Pump Make: Little Giant Model Serial No. 4MP 4AWS

Nitrification Field: No Fields 1 Square Feet 178400/600 Linear Feet 266

No Lines 4@60' 4@30' Trench Width 2-3' Max Trench Bottom Depth 3

[X] New System [ ] Repair System Type: I, II, III, (IV), V, VI

System Description: Pres Dosed - 16" PBPS

Repair System Description: Same

Maintenance Agreement Required: [X] Yes [ ] No

[X] House/Mod. Home No. Bedrooms 4 4AWS

[ ] Mobile Home No. Bathrooms 2.5

[ ] Business No. Employees

[ ] Other

Gravel Depth N/A [ ] Slab [X] Crawl Space [ ] Basement w/plumbing [ ] Basement wo/plumbing

Water Supply: [X] Individual [ ] Public [ ] Community

Comments:/Conditions: 2' on 8' Centers 3' on 9' Centers


3/5/04 - Moved to Repair Field and auger field with Repair Area 60'

Comments:/Conditions: AC can't be issued until house plan is reviewed

3@90'x3' Pres Dosed PPBAS lines installed

INITIAL SITE SKETCH

(1"=50')

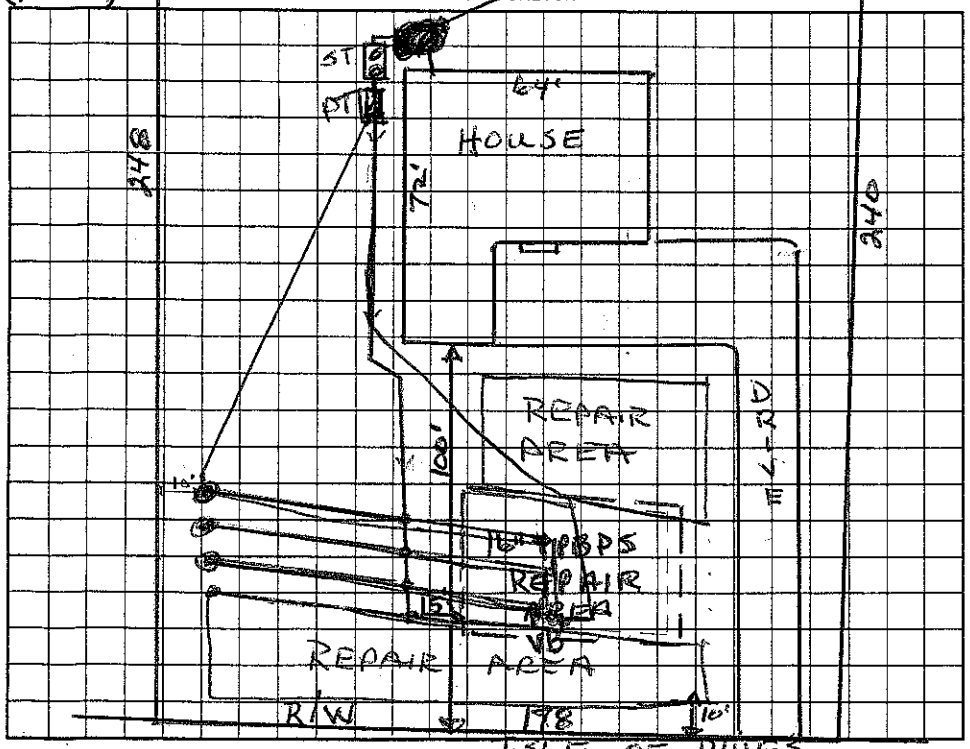

AS BUILT SKETCH

Permit can be suspended or revoked if any false information is supplied toward securing the permit/any unauthorized changes are made to the site/any unauthorized changes are made in the installation of the system. Improvement Permit with plat valid without expiration. Improvement Permit with site plan valid for sixty months. Authorization to Construct is valid for a period equal to that of Improvement Permit – not to exceed sixty months.

Signed: X Dwayne Haney date 11/21/04

Improvement Permit by: Wesley Sparks RS. date 1/9/04

Authorization to Construct by: Wesley Sparks RS. date 3/9/04

Installed by: Richard Cabe

Operation Permit by: Wesley Sparks RS. date 9/24/04

Existing System Inspection by: date

HEALTH DEPT. COPY: WHITE OWNER COPY (FINAL): YELLOW OWNER COPY (INITIAL): PINK