IREDELL COUNTY HEALTH DEPARTMENT

STATESVILLE 704-878-5305 3500 Paid MOORESVILLE 704-664-5281

IMPROVEMENT PERMIT / AUTHORIZATION TO CONSTRUCT / OPERATION PERMIT / EXISTING SYSTEM INSPECTION

PERMIT# 119174 PIN# 4636 30 0379 DATE 1/9/04

OWNER OR CONTRACTOR Folgerbug Builders LLC PHONE: Business 980-721-1249 Home

ADDRESS PO Box 456 E Mooresville, NC 28117

LOCATION Isle of Pines Rd, 1100 Tl Isle of Pines Rd. first lot on (L) past Bennett Rd.

SUBDIVISION Bay Ridge BLOCK / SECTION LOT 2 LOT AREA 1.01 Ac SITE CLASS PS DESIGN FLOW 360 L.T.A.R. .3

Septic Tank: 1000 Gallons: STB 317 Date 1/26/04

Pump Tank: 1000 Gallons: PT 283 Date 1/27/04

Pump Make: LittleGiant Model Serial No. 4440

Nitrification Field: No Fields 1 Square Feet 402/603 Linear Feet 201

No Lines 3@67' Trench Width 2-3 Max Trench Bottom Depth 3' Gravel Depth N/A

☒ New System ☐ Repair System Type: I, II, III, IV, V, VI

System Description: Pres Dosed - 16" PPBPS

Repair System Description: Same

Maintenance Agreement Required: ☒ Yes ☐ No

☐ House/Mod. Home No. Bedrooms 3

☐ Mobile Home No. Bathrooms 2.5

☐ Business No. Employees

☐ Other


☐ Slab ☒ Crawl Space ☐ Basement w/plumbing ☐ Basement wo/plumbing

Water Supply: ☒ Individual ☐ Public ☐ Community

Comments:/Conditions:

Comments:/Conditions: Need Home Plan before AC may be issued. Vehicles Parked over drainfield area - 9/24/04

INITIAL SITE SKETCH

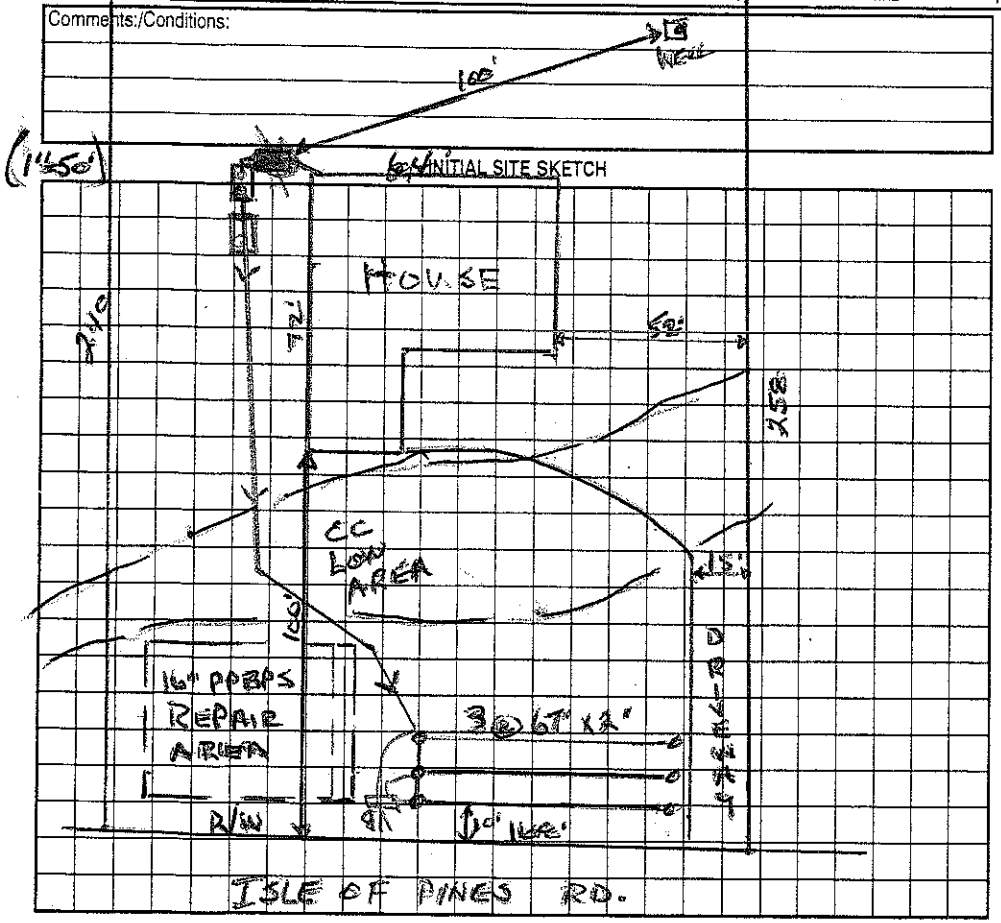

AS BUILT SKETCH

Permit can be suspended or revoked if any false information is supplied toward securing the permit/any unauthorized changes are made to the site/any unauthorized changes are made in the installation of the system. Improvement Permit with plat valid without expiration. Improvement Permit with site plan valid for sixty months. Authorization to Construct is valid for a period equal to that of Improvement Permit – not to exceed sixty months.

Signed: * Douglas Haney date 1/21/04

Improvement Permit by: Wesley Sparks RS. date 1/5/04

Authorization to Construct by: Wesley Sparks RS date 3/9/04

Installed by:

Operation Permit by: Wesley Sparks RS. date 9/24/04

Existing System Inspection by: date

HEALTH DEPT. COPY: WHITE OWNER COPY (FINAL): YELLOW OWNER COPY (INITIAL): PINK