PERMIT # 151504 PIN # 4636301527

IREDELL COUNTY HEALTH DEPARTMENT – *Environmental Health Division*

Statesville Office 704-878-5305 Mooresville Office 704-660-3625

PRIVATE DRINKING WATER WELL PERMIT

Type of Permit (circle one) (New) Repair Abandonment

APPLICANT INFORMATION

Scott Meesters | 377 Isle of Pines Mooresville 28117 | 704-662-0950

Name | Full Address | Telephone #

PROPERTY INFORMATION


Brawley School Rd, TL Isle of Pines, on L

Directions to Site

377 Isle of Pines Dr. | Ivy Ridge | 2

Physical location of proposed well (street address) | Subdivision | Lot #

Initial Site Sketch

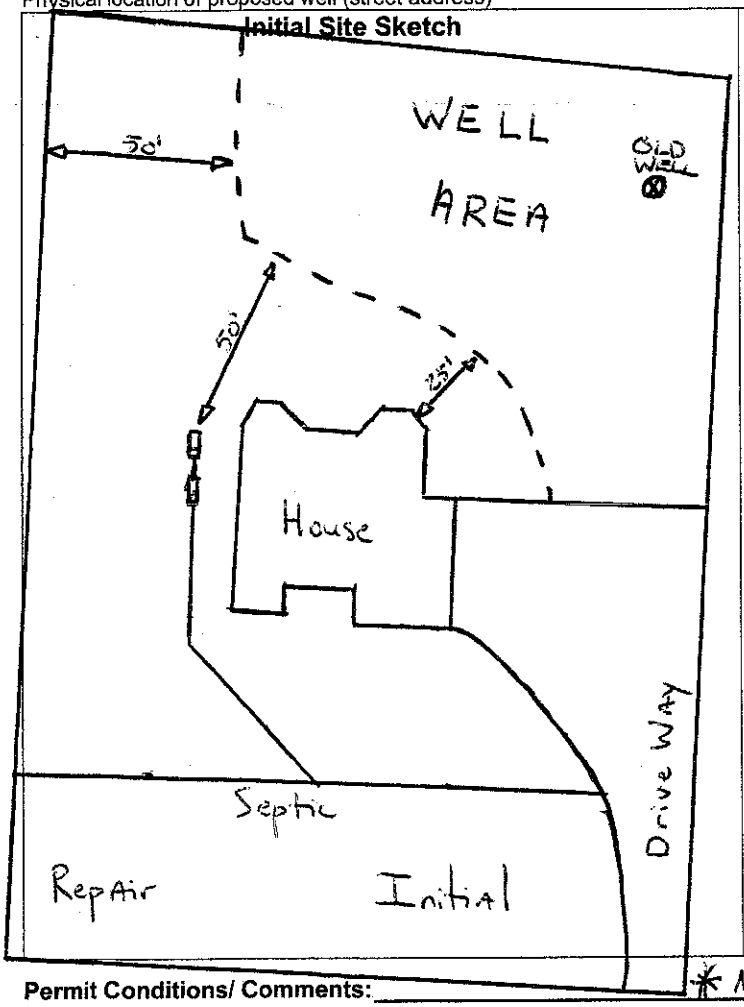

"As Built" Sketch

Permit Conditions/ Comments: * New well can be no closer than 50' to septic + no closer than 25' to house * Old well must be capped if not abandond

Well Permit Issued By: B-Allen **Date:** 7-2-08

(Permit is valid for 5 years from date issued. This permit may be revoked if it is determined there has been a material change in any fact or circumstance upon which the permit is issued. Actions of the employees of the Iredell County Health Department shall in no way be taken as a guarantee that this well will produce water of any particular quantity or quality or for any amount of time. Employees of the Iredell County Health Department assume no liability for any damages, either direct or consequential which may be caused by this well.)

Well GPS Coordinates Lat: _____ **Long:** _____ **Well Contractor** _____ **Contractor Cert #** _____

Grout Inspection By: _____ **Date:** _____ **or Certification for Grouting Not Witnessed by Dept** _____ **Date:** _____

Well Head Inspection (check when completed) Grout to Ground Surface ☐ Well Contractor ID Plate ☐ Pump Installer ID Plate ☐ Sample Port ☐ Access Port / Vent ☐ Well Seal ☐ Well Head 12 inches / Pit less Adaptor 8 inches above grade ☐

Well Head Inspection By: _____ **Date:** _____

Certificate of Completion by: _____ **Date:** _____ **Water Samples By:** _____ **Date:** _____

Attachments: Form GW-1a (***required except for abandonment***) ☐ Form GW 30 ☐ Water Sample Results ☐ Plat ☐

Health Dept. Copy - White Applicant Certificate of Completion - Yellow Applicant Well Construction Permit - Pink