IREDELL COUNTY HEALTH DEPARTMENT

STATESVILLE 704-878-5305 130.00 Paid MOORESVILLE 704-664-5281

IMPROVEMENT PERMIT / AUTHORIZATION TO CONSTRUCT / OPERATION PERMIT / EXISTING SYSTEM INSPECTION

PERMIT# 117173 PIN# 4636 30 1753 DATE 1/9/04

OWNER OR CONTRACTOR Flagship Builders LLC PHONE: Business 980 721 1249 Home

ADDRESS PO Box 4568 Mooresville, NC. 28117

LOCATION Dennett Rd, 1100 TL Isle Pines TL Dennett Rd Corner lot on R

SUBDIVISION Hoy Ridge BLOCK / SECTION LOT 1 LOT AREA 1 Ac SITE CLASS. PS DESIGN FLOW 480 Aus L.T.A.R. .35

Septic Tank: 1000 Gallons; STB 3172 Date 6/28/04

Pump Tank: 1000 Gallons; PT 27 Date 6/9/04

Pump Make: Little Giant Model AOS Serial No. 4HP Aus

Nitrification Field: No Fields 1 Square Feet 1800 Linear Feet 400

No Lines 4 @ 100' Trench Width 3' Max Trench Bottom Depth 3'

X New System ☐ Repair System Type: I, II, III, IV, V, VI

System Description: Pres Non. → Type 3

Repair System Description: Pres Non-red 16" PPBPS

Maintenance Agreement Required: ☐ Yes ☐ No

X House/Mod. Home No. Bedrooms 4 AUS

☐ Mobile Home No. Bathrooms 2.5

☐ Business No. Employees

☐ Other

Gravel Depth N/A ☐ Slab X Crawl Space ☐ Basement w/plumbing ☐ Basement wo/plumbing


Water Supply: X Individual ☐ Public ☐ Community

Comments:/Conditions: Drainfield and tanks situated out of drainageway that drains this property.


Comments:/Conditions: Need house plan before AC may be issued.

(1" = 50')

INITIAL SITE SKETCH

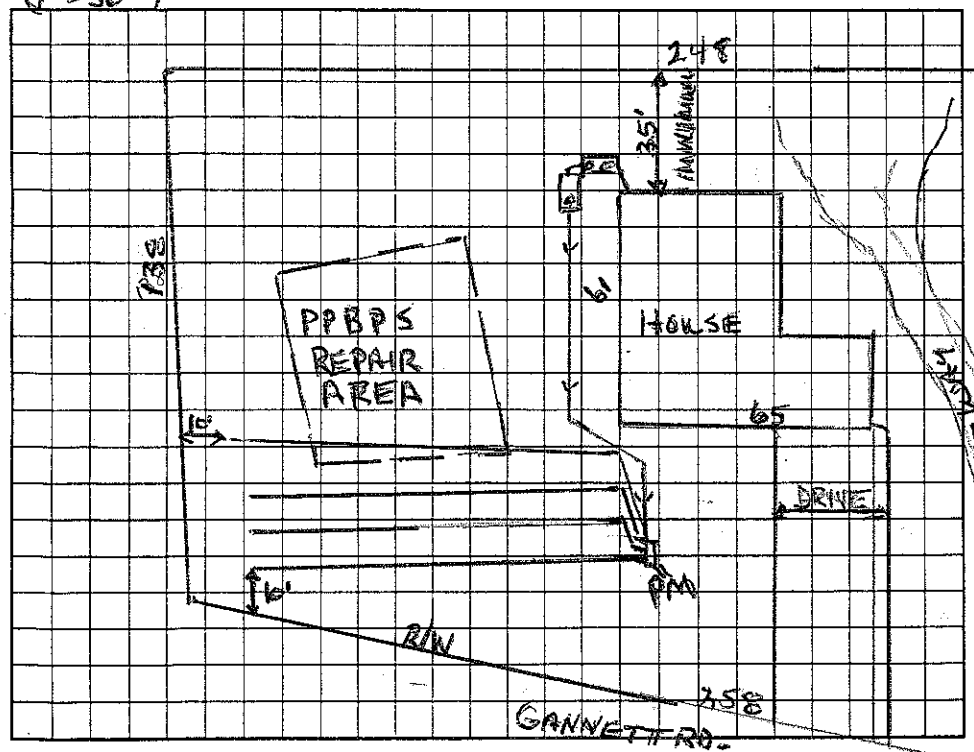

AS BUILT SKETCH

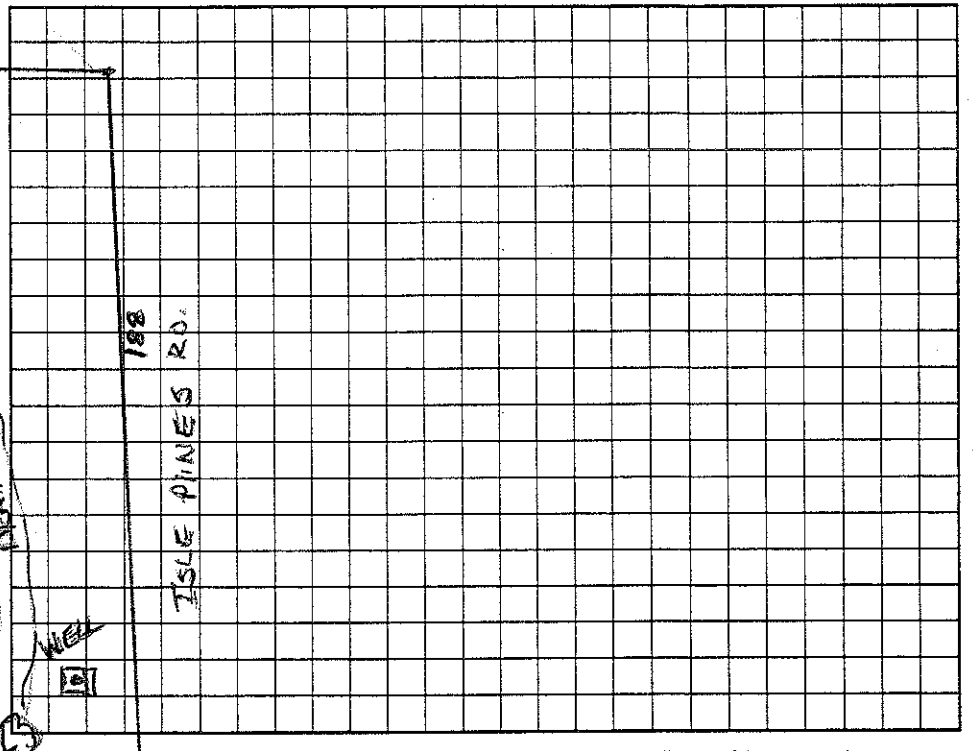

Permit can be suspended or revoked if any false information is supplied toward securing the permit/any unauthorized changes are made to the site/any unauthorized changes are made in the installation of the system. Improvement Permit with plat valid without expiration. Improvement Permit with site plan valid for sixty months. Authorization to Construct is valid for a period equal to that of Improvement Permit – not to exceed sixty months.

Signed: * Wayne Haney date 1/21/04

Improvement Permit by: Wesley Sparks RS date 1/9/04

Authorization to Construct by: Wesley Sparks RS. date 3/9/04

Installed by: Unknown

Operation Permit by: Wesley Sparks RS date 9/24/04

Existing System Inspection by: date

HEALTH DEPT COPY: WHITE OWNER COPY (FINAL): YELLOW OWNER COPY (INITIAL): PINK