IREDELL COUNTY HEALTH DEPARTMENT

STATESVILLE 704-878-5305 155.00 Paid MOORESVILLE 704-664-5281

IMPROVEMENT PERMIT / AUTHORIZATION TO CONSTRUCT / OPERATION PERMIT / EXISTING SYSTEM INSPECTION

PERMIT# 075199 PIN# 4636307807 PT 4636-30-5774 DATE 11-13-03

OWNER OR CONTRACTOR The Depot Group PHONE: Business 664-6407 Home Mobile 650-0003

ADDRESS 862 Brawley School Rd Suite 201 Mooresville, NC 28117

LOCATION Brawley School Rd TL Isle of Pines TL Gannett on Corner of Gannett & Barton Place

SUBDIVISION Lake View Hts BLOCK / SECTION 1 LOT 14 LOT AREA .69 Acre SITE CLASS. PS DESIGN FLOW 360gpd L.T.A.R. .3

Septic Tank: 1000 Gallons; STB 794 Date 5/24/04

Pump Tank: 1000 Gallons; PT 283 Date 5/15/04

Pump Make: Gould's Model WE03J2AA Serial No.

Nitrification Field: No Fields 1 Square Feet 900' Linear Feet 300'

No Lines 3@100' Trench Width 36" Max Trench Bottom Depth 26" Gravel Depth N/A

☒ New System ☐ Repair System Type: I, II, III, IV, V, VI

System Description: Pump-PM-25% Reduction

Repair System Description: Same

Maintenance Agreement Required: ☐ Yes ☐ No

☒ House/Mod. Home No. Bedrooms 3

☐ Mobile Home No. Bathrooms 2.5

☐ Business No. Employees

☐ Other


☐ Slab ☒ Crawl Space ☐ Basement w/plumbing ☐ Basement wo/plumbing

Water Supply: ☒ Individual ☐ Public ☐ Community


Comments:/Conditions: * Supply line - 12" clear separation distance where supply line crosses storm drain or sewer line is of ductile iron pipe for 5' on either side of crossing.

Comments:/Conditions: Please keep Septic System at least 10' From PL, drainfield 25' from Storm drain & 100' fr well. Pressure, elect & alarm 7/7/04

Scale 1:40 INITIAL SITE SKETCH

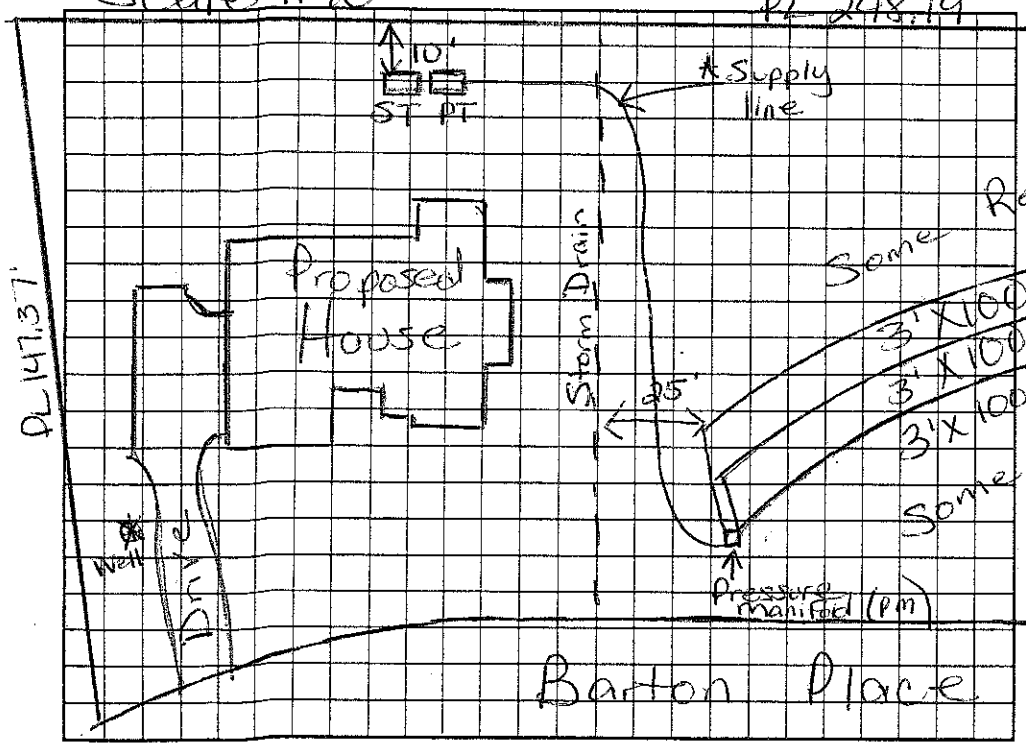

AS BUILT SKETCH

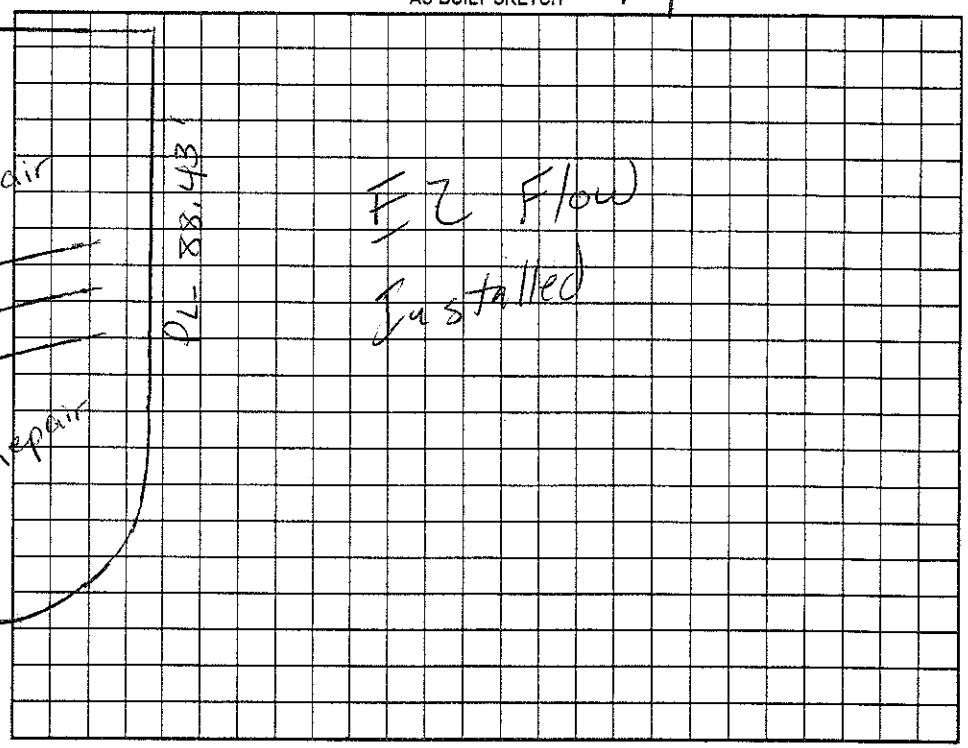

Permit can be suspended or revoked if any false information is supplied toward securing the permit/any unauthorized changes are made to the site/any unauthorized changes are made in the installation of the system. Improvement Permit with plat valid without expiration. Improvement Permit with site plan valid for sixty months. Authorization to Construct is valid for a period equal to that of Improvement Permit – not to exceed sixty months.

Signed: John H. Depot S/R. date 11/14/03 Installed by: R+H

Improvement Permit by: Maria H. Dobson R.S. date 11/14/03 Operation Permit by: Maria H. Dobson R.S. date 7/7/04

Authorization to Construct by: Maria H. Dobson R.S. date 11/14/03 Existing System Inspection by: date

HEALTH DEPT. COPY: WHITE OWNER COPY (FINAL): YELLOW OWNER COPY (INITIAL): PINK