IREDELL COUNTY HEALTH DEPARTMENT

Statesville Office (704) 878-5305 Mooresville Office (704) 660-3625

2-2:30 BP

PERMIT # 201006

IMPROVEMENT PERMIT / AUTHORIZATION TO CONSTRUCT / OPERATION PERMIT / EXISTING SYSTEM

PIN # 4636-30-6213 ✓

APPLICANT: Edge Building Company APPLICANT ADDRESS: PO Box 4946 Mooresville NC 28117

SITE ADDRESS: 134 Gannett Dr Mooresville NC 28117 PHONE: 980-721-6778 ALT. PHONE:

SITE DIRECTIONS: Brawley Sch Rd, TL on Isle of Pines, TL on Gannett Dr, TR on Ruby, Lot on L corner

SUBDIVISION: CL+T SECTION: 5 LOT # 1752 LOT AREA: 1.15 ac DESIGN FLOW: 480gpd L.T.A.R.: 0.3


Septic Tank	1000 (gal)	STB	1194	Date		☑ New System ☐ Repair ☐ Expansion System Type: I II III IV V VI	☑ Residence	No. Bedrooms	4
Pump Tank	1000 (gal)	PT	2831	Date	2-7-15	System Description: PM 25% Reduction	☐ Business	No. Persons	8
Pump Make	Zoeller Model	N	153-B	Serial #		Repair System Description: LP PPBPS	☐ Other	No. Employees	
# Nitrification Fields	1 # Lines	4		Linear Ft:	400	Maintenance Agreement Required: ☐ YES ☑ NO	☑ Slab	☐ Crawl Space	
Trench Width	36" Max. Trench Bottom Depth	36"		Gravel Depth	N/A	☐ GRAVITY ☑ PRESSURE	☑ Basement w/plumbing	☐ Basement w/o plumbing	

Water Supply: ☑ Private ☐ Public ☐ Community

Comments / Conditions: * INSTALL ALL TRENCHES 36" DEEP *

Tanks are 8ft from House, below house found.
Tanks ~ 10ft to Patio
Tanks installed perpendicular to House
Used Quick 4 Ifor

INITIAL SITE SKETCH

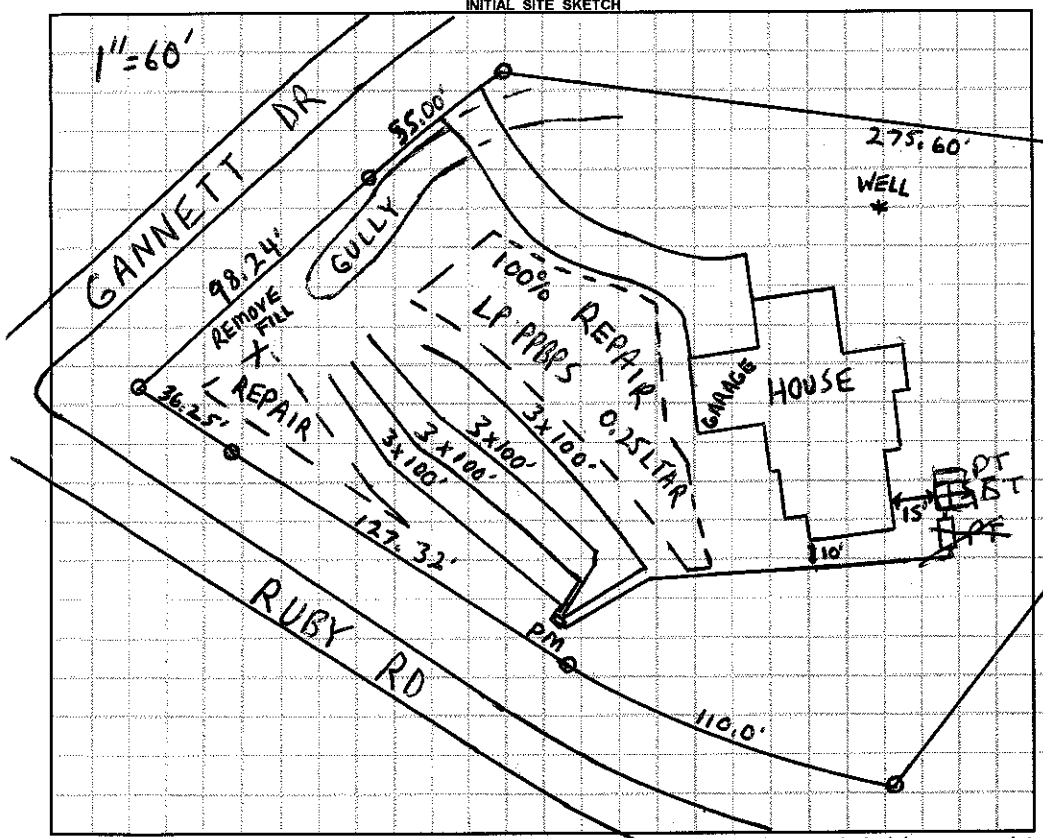

AS BUILT SKETCH

8/28/15 Checked tanks, lines, supply line & manifold

Permit can be suspended or revoked if any false information is supplied toward securing the permit / any unauthorized changes are made to the site / any unauthorized changes are made in the installation of the system. **CONTACT A LOCATOR SERVICE PRIOR TO ANY EXCAVATION**

☐ **IMPROVEMENT PERMIT** *with plat valid without expiration.* ☑ **IMPROVEMENT PERMIT** *with site plan valid for 60 mos.* ☑ **AUTHORIZATION TO CONSTRUCT** *valid for period equal to IMPROVEMENT PERMIT--not to exceed 60 mo.*

Owner / Applicant Signature: Jill Byrd Date: 5/19/14 Installed by: Russell Williams

IMPROVEMENT PERMIT by: Date: 5-18-14 OPERATION PERMIT by: Date: SEP 28 2015

AUTHORIZATION TO CONSTRUCT by: Date: 3-18-14 Existing System Inspected by: Date:

APPROVED

Health Dept. Copy - WHITE Applicant (Final Approval) - YELLOW Applicant (Conditional Approval) - PINK