IREDELL COUNTY HEALTH DEPARTMENT

STATESVILLE 704-878-5305 $120 MOORESVILLE 704-664-5281

IMPROVEMENT PERMIT / AUTHORIZATION TO CONSTRUCT / OPERATION PERMIT / EXISTING SYSTEM INSPECTION

PERMIT# 120294 PIN# 4636-30-6656 DATE 5/17/04

OWNER OR CONTRACTOR L. Shaun Ogden Const. LLC PHONE: Business 704-663-3531 Home

ADDRESS PO Box 1281 Davidson NC 28036

LOCATION BSR, TL Isle of Pines, TL Garret, on Lt 1st Past Barton Pl.

SUBDIVISION Lakeview Hts BLOCK / SECTION LOT 13 LOT AREA 0.69ac SITE CLASS PS DESIGN FLOW 480 L.T.A.R. 0.3

Septic Tank: 1000 Gallons; STB 312 Date 6/6/05
Pump Tank: 1000 Gallons; PT 27 Date 6/6/05
Pump Make: LittleGiant Model 9EH Serial No.
Nitrification Field: No Fields 1 Square Feet 1200 Linear Feet 400
No Lines 4 Trench Width 36" Max Trench Bottom Depth 36" Gravel Depth —

☒ New System ☐ Repair System Type: I, II, III, IV, V, VI
System Description: PM 25% Reduction
Repair System Description: LP Paved Block
Maintenance Agreement Required: ☐ Yes ☒ No

☒ House/Mod. Home ☐ Mobile Home ☐ Business ☐ Other
No. Bedrooms 4 No. Bathrooms 4 No. Employees

☐ Slab ☒ Crawl Space ☐ Basement w/plumbing ☐ Basement wo/plumbing

Water Supply: ☒ Individual ☐ Public ☐ Community


Comments:/Conditions:

1"=50'


Comments:/Conditions:

Supply has been driven over and top 2 drainlines. Infiltrators installed

INITIAL SITE SKETCH

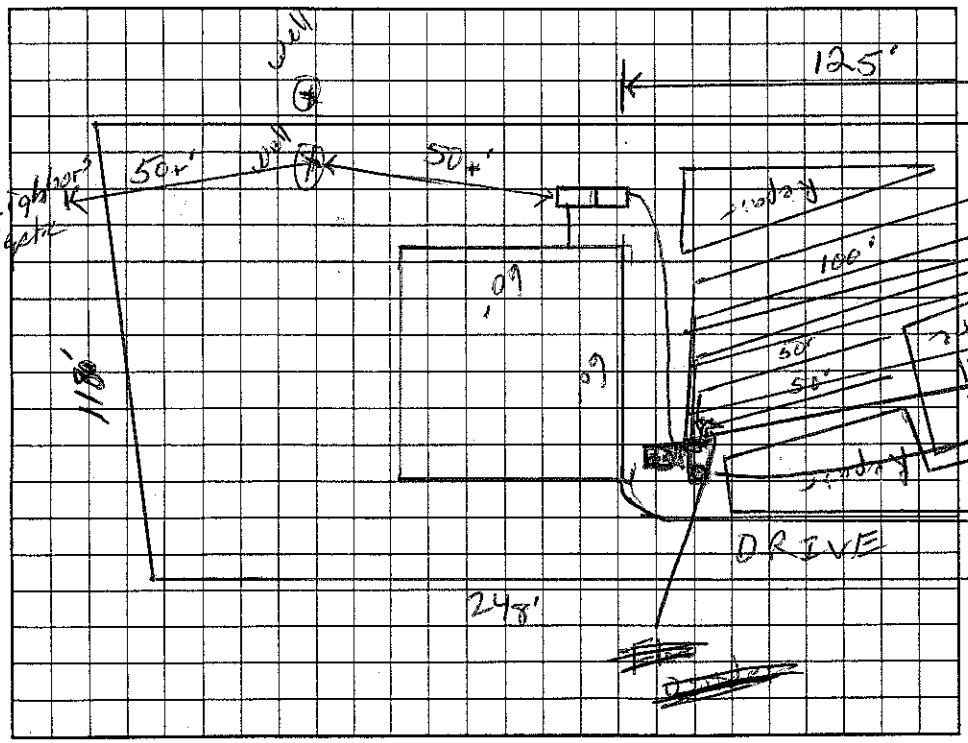

AS BUILT SKETCH

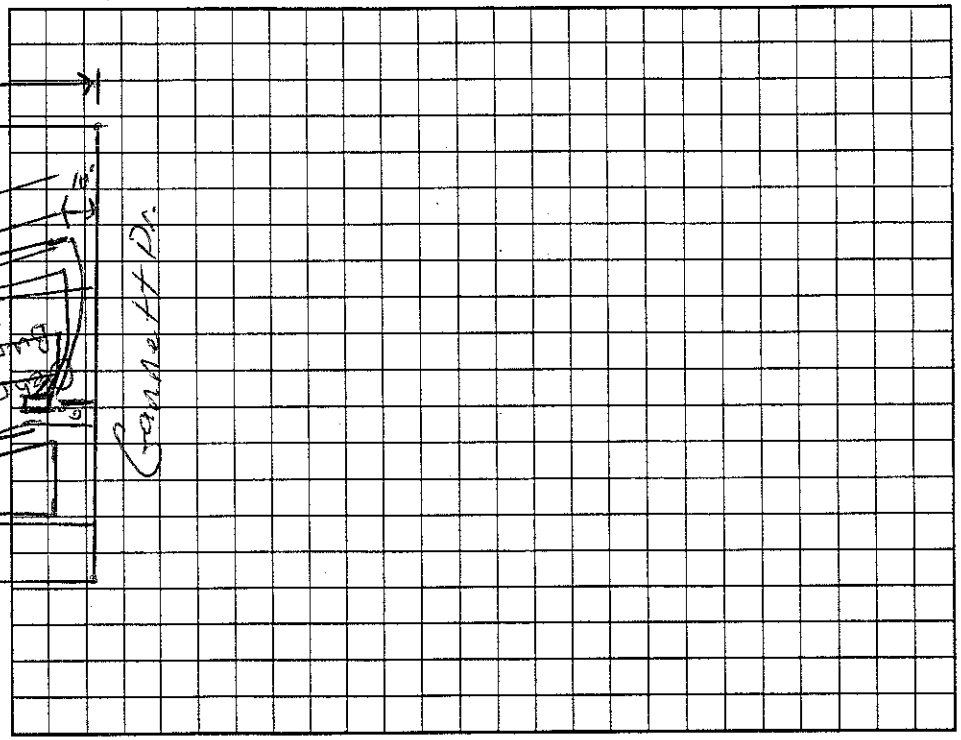

Permit can be suspended or revoked if any false information is supplied toward securing the permit/any unauthorized changes are made to the site/any unauthorized changes are made in the installation of the system. Improvement Permit with plat valid without expiration. Improvement Permit with site plan valid for sixty months. Authorization to Construct is valid for a period equal to that of Improvement Permit – not to exceed sixty months.

Signed: L. Ogden date 5/25/04

Improvement Permit by: date 5/17/04

Authorization to Construct by: date 1/26/05

Installed by: Richard Abernathy

Operation Permit by: Wendy Sparks R.S. date 10/19/05

Existing System Inspection by: date

HEALTH DEPT. COPY: WHITE OWNER COPY (FINAL): YELLOW OWNER COPY (INITIAL): PINK