IREDELL COUNTY HEALTH DEPARTMENT

$130

STATESVILLE 704-878-5305 MOORESVILLE 704-664-5281

IMPROVEMENT PERMIT / AUTHORIZATION TO CONSTRUCT / OPERATION PERMIT / EXISTING SYSTEM INSPECTION

PERMIT# 11886570 PIN# 4636307486

OWNER OR CONTRACTOR The Dupont Group Inc PHONE: Business 660-0402 Johnny DATE 2/27/04

ADDRESS 110 Charleston Dr. Suite 108 Mooresville NC 28117 Home 650-0003

LOCATION Brawley School Rd TL Isle of Pines TL Gannett 7th lot on left

SUBDIVISION Lakeview Hts. BLOCK / SECTION LOT 11 LOT AREA .69 Acre SITE CLASS. PS DESIGN FLOW 360gpd L.T.A.R. .3

Septic Tank: 1000 Gallons; STB 794 Date 1

Pump Tank: Gallons; PT Date

Pump Make: Model Serial No.

Nitrification Field: No Fields 1 Square Feet 900 Linear Feet 300

No Lines 4 Trench Width 36" Max Trench Bottom Depth 36" Gravel Depth N/A

☒ New System ☐ Repair System Type: I, II, (III), IV, V, VI

System Description: Gravity - 25% Reduction

Repair System Description: Shallow - 25% Reduction

Maintenance Agreement Required: ☐ Yes ☒ No Not Initially

☒ House/Mod. Home No. Bedrooms 3

☐ Mobile Home No. Bathrooms 3½

☐ Business No. Employees

☐ Other


☐ Slab ☐ Crawl Space ☐ Basement w/plumbing ☐ Basement wo/plumbing

Water Supply: ☒ Individual ☐ Public ☐ Community


Comments:/Conditions: Keep Septic System at least 10' From PL & >50' From any well
Keep well at least 25' From house & 50' from PL

Comments:/Conditions: Okay to use Distribution box instead of "drop boxes" if lines are equalin length.
Keep well 50' From PL

INITIAL SITE SKETCH 1:50

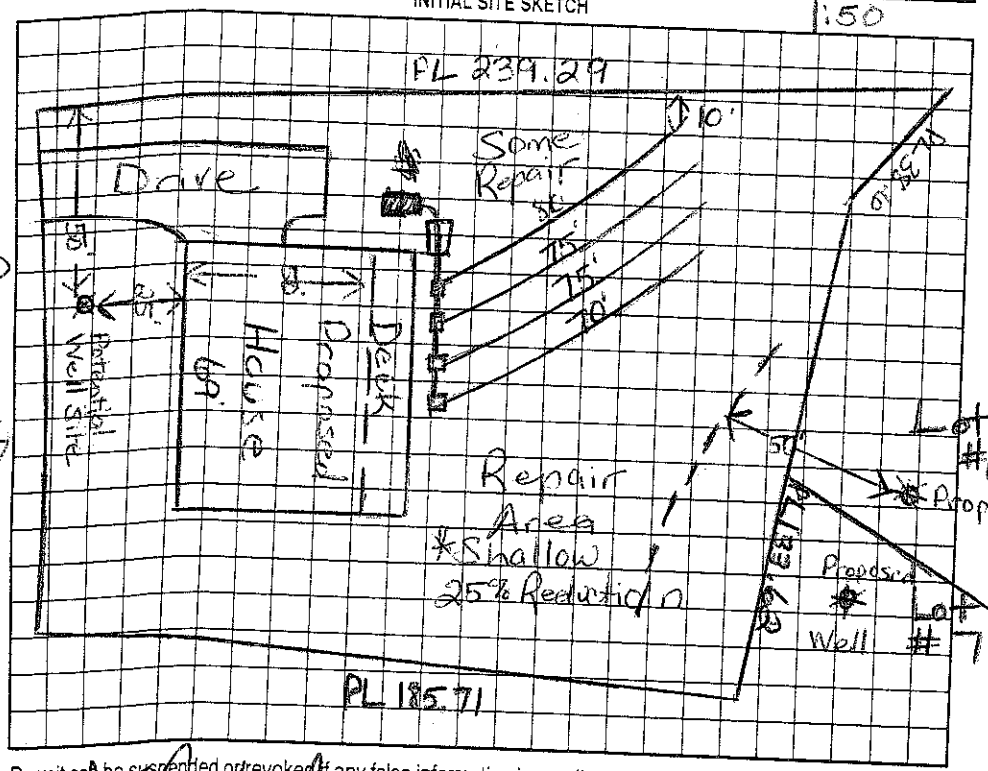

AS BUILT SKETCH

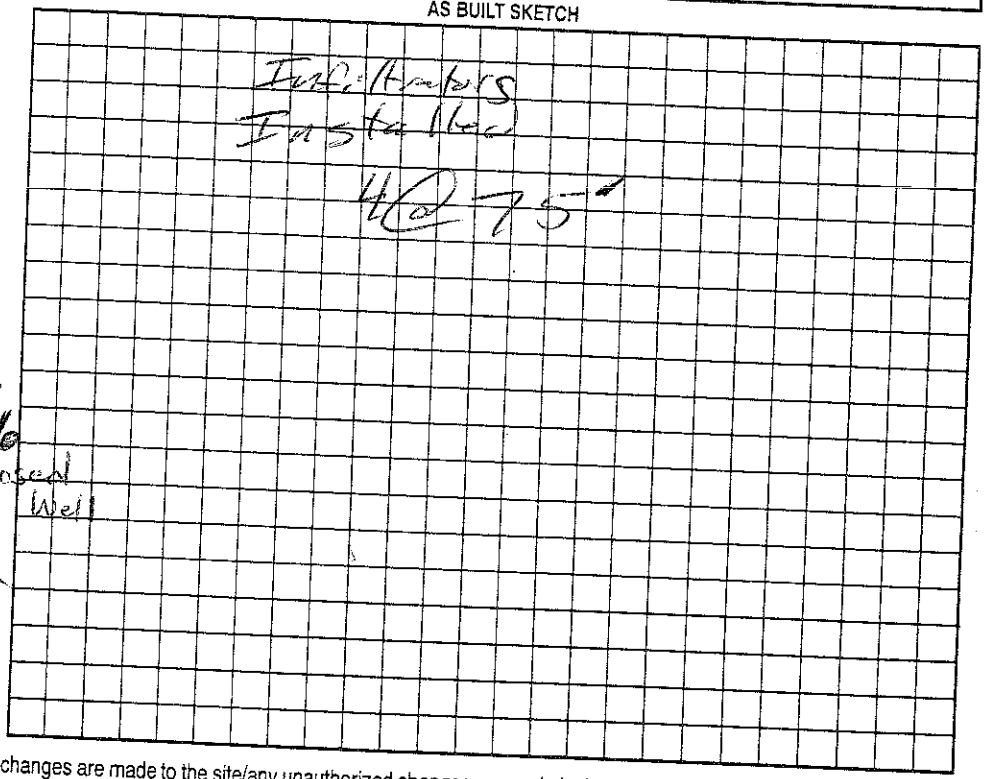

Gannett

Permit can be suspended or revoked if any false information is supplied toward securing the permit/any unauthorized changes are made to the site/any unauthorized changes are made in the installation of the system. Improvement Permit with plat valid without expiration. Improvement Permit with site plan valid for sixty months. Authorization to Construct is valid for a period equal to that of Improvement Permit -- not to exceed sixty months.

Signed John H Dupont date 3/4/04 Installed by: Abernathy

Improvement Permit by: Maina H Watson RS date 2/27/04 Operation Permit by: RS date 3/24/05

Authorization to Construct by: Maina H Watson RS date 2/27/04 Existing System Inspection by: date

HEALTH DEPT. COPY: WHITE OWNER COPY (FINAL): YELLOW OWNER COPY (INITIAL): PINK