IREDELL COUNTY HEALTH DEPARTMENT

STATESVILLE 704-878-5305 $130 MOORESVILLE 704-664-5281

IMPROVEMENT PERMIT / AUTHORIZATION TO CONSTRUCT / OPERATION PERMIT / EXISTING SYSTEM INSPECTION

PERMIT# 120 295 PIN# 4636-30-7537 DATE 5/17/04

OWNER OR CONTRACTOR L. Shaun Ogden Const. LLC / Campbell Homes PHONE: Business 704-662-3531 Home

ADDRESS PO Box 1281 Davidson, NC 28036

LOCATION BSR, TL Isle of Pines, TL Gannett, on Lt across From Ruby Rd

SUBDIVISION Lakeview Hts. BLOCK / SECTION LOT 12 LOT AREA 0.69 Ac SITE CLASS. PS DESIGN FLOW 450 L.T.A.R. 0.3

Septic Tank: 1000 Gallons; STB X2F Date 3/30/05
Pump Tank: 1000 Gallons; PT Box Date 5/3/05
Pump Make: Zoeller Model N-97 Serial No.
Nitrification Field: No Fields 1 Square Feet 1200 Linear Feet 400
No Lines 5@80' Trench Width 36" Max Trench Bottom Depth 36" Gravel Depth —

☒ New System ☐ Repair System Type: I, II, III, IV, V, VI
System Description: PM 25% Reduction
Repair System Description: LP Panel Block
Maintenance Agreement Required: ☐ Yes ☒ No

☒ House/Mod. Home No. Bedrooms 4
☐ Mobile Home No. Bathrooms 4
☐ Business No. Employees
☐ Other
☐ Slab ☒ Crawl Space ☐ Basement w/plumbing ☐ Basement wo/plumbing


Water Supply: ☒ Individual ☐ Public ☐ Community

Comments:/Conditions:


1" = 50'

Comments:/Conditions:

INITIAL SITE SKETCH

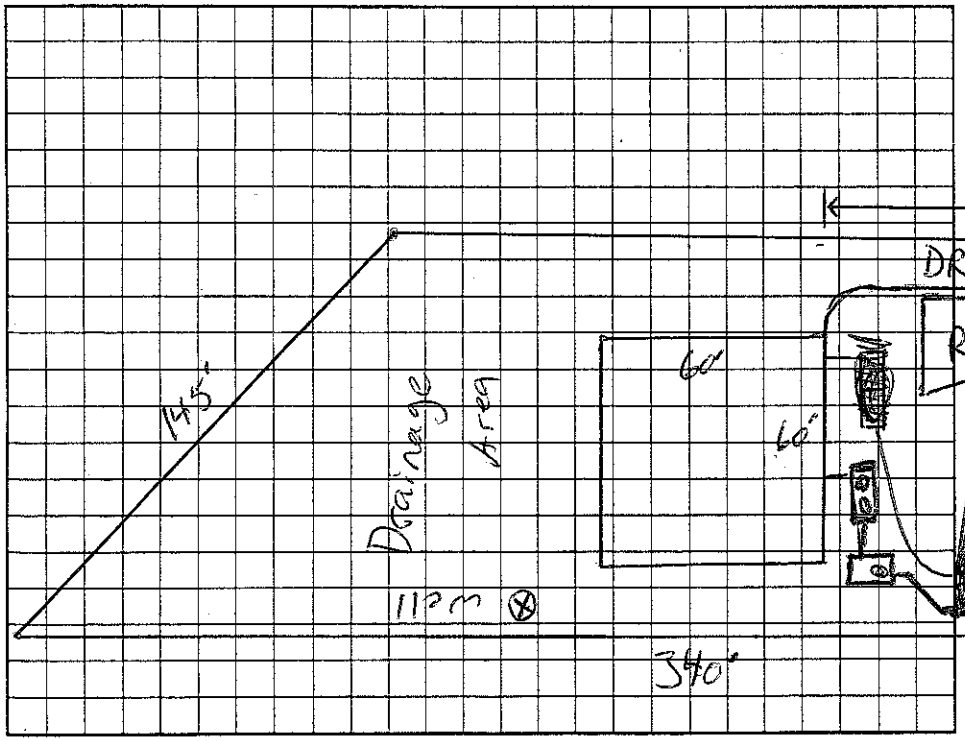

AS BUILT SKETCH

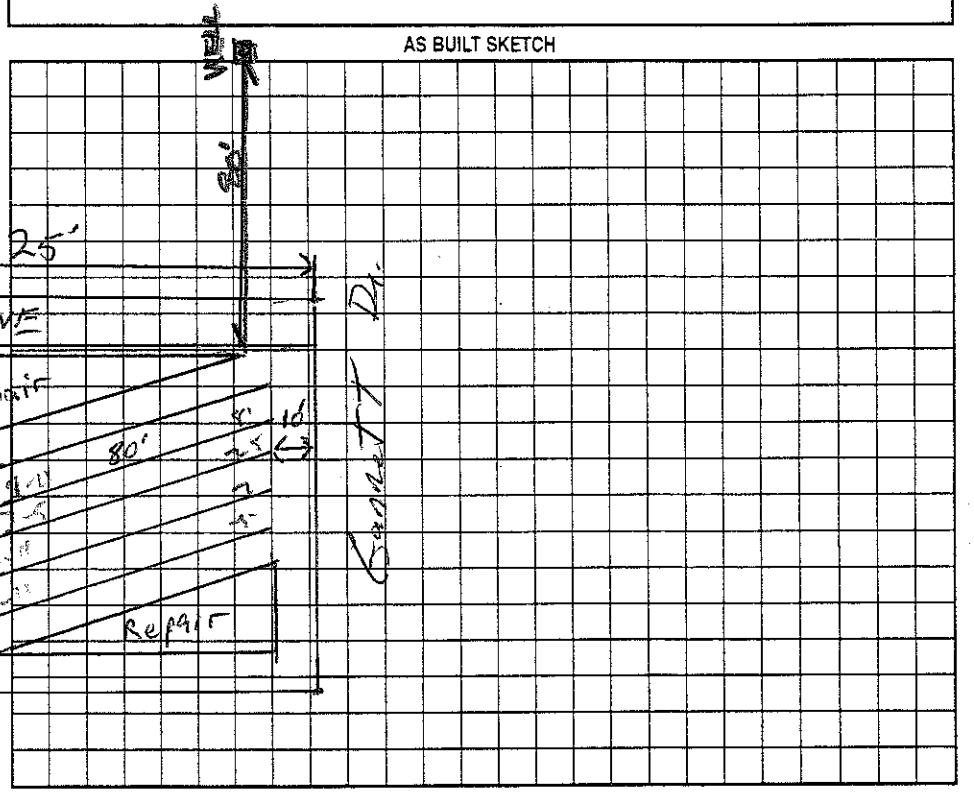

Permit can be suspended or revoked if any false information is supplied toward securing the permit/any unauthorized changes are made to the site/any unauthorized changes are made in the installation of the system. Improvement Permit with plat valid without expiration. Improvement Permit with site plan valid for sixty months. Authorization to Construct is valid for a period equal to that of Improvement Permit – not to exceed sixty months.

Signed: L. Shaun Ogden date 5/25/04

Improvement Permit by: [signature] RS date 5/17/04

Authorization to Construct by: [signature] RS date 11/10/04

Installed by: Rowan Septic Tank

Operation Permit by: Wesley Sparks RS date 10/24/05

Existing System Inspection by: date

HEALTH DEPT. COPY: WHITE OWNER COPY (FINAL): YELLOW OWNER COPY (INITIAL): PINK