IREDELL COUNTY HEALTH DEPARTMENT

STATESVILLE 704-878-5305 130.00 Paid MOORESVILLE 704-664-5281

IMPROVEMENT PERMIT / AUTHORIZATION TO CONSTRUCT / OPERATION PERMIT / EXISTING SYSTEM INSPECTION

PERMIT# 12088 PIN# 4636307863 DATE 6-4-04

OWNER OR CONTRACTOR The Dupont Group PHONE: Business 660-0402 Home 650-0003 Johnny

ADDRESS 862 Brawley School Rd Mooresville

LOCATION 112 Barton Pl ↘ Brawley School Rd TL Isle of Pines TL Gannett TL Barton on right

SUBDIVISION Lakeview Hts BLOCK / SECTION ___ LOT 15 LOT AREA .70 Acre SITE CLASS PS DESIGN FLOW 480gpd L.T.A.R. .3

Septic Tank: 1000 Gallons; STB 312 Date 3/29/05
Pump Tank: 1000 Gallons; PT 27 Date 11/16/05
Pump Make: LittleGiant Model 9EH Serial No. ___
Nitrification Field: No Fields ___ Square Feet 1200 Linear Feet 400
No Lines 6 Trench Width 36" Max Trench Bottom Depth 36" Gravel Depth N/A

☒ New System ☐ Repair System Type: I, II, (III), IV, V, VI
System Description: Pump-PM-25% Reduction
Repair System Description: Pump - Panel Block
Maintenance Agreement Required: ☐ Yes ☒ No

☒ House/Mod. Home ☐ Mobile Home ☐ Business ☐ Other
No. Bedrooms 4 No. Bathrooms 2.5 No. Employees ___
☐ Slab ☐ Crawl Space ☒ Basement w/plumbing ☐ Basement wo/plumbing


Water Supply: ☐ Individual ☒ Public ☐ Community

Comments/Conditions: Keep Septic System at least 10' from PL
Note: Keep Drainfield 15' From cut if >2ft
IF Drainfield higher than foundation drain
Stay back 25ft.

Comments/Conditions: Tanks & lines checked by GM 4/05

Scale 1:50

INITIAL SITE SKETCH

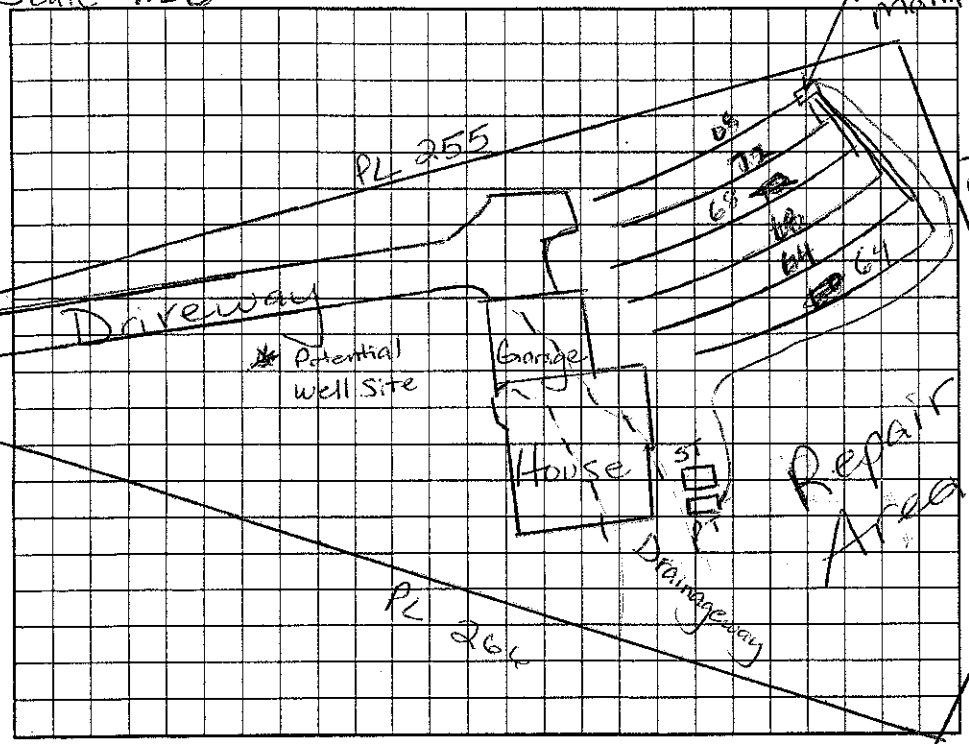

AS BUILT SKETCH

Permit can be suspended or revoked if any false information is supplied toward securing the permit/any unauthorized changes are made to the site/any unauthorized changes are made in the installation of the system. Improvement Permit with plat valid without expiration. Improvement Permit with site plan valid for sixty months. Authorization to Construct is valid for a period equal to that of Improvement Permit – not to exceed sixty months.

Signed: Shannon Combs date 6/9/04
Improvement Permit by: Maria H. Dolan RS date 6/4/04
Authorization to Construct by: Maria H. Dolan RS date 6/4/04
Installed by: Richard Abernathy
Operation Permit by: Maria H. Dolan RS date 4/22/05
Existing System Inspection by: ___ date ___

HEALTH DEPT. COPY: WHITE OWNER COPY (FINAL): YELLOW OWNER COPY (INITIAL): PINK