IREDELL COUNTY HEALTH DEPARTMENT

STATESVILLE 704-878-5305 MOORESVILLE 704-664-5281

IMPROVEMENT PERMIT / AUTHORIZATION TO CONSTRUCT / OPERATION PERMIT / EXISTING SYSTEM INSPECTION

PERMIT# 075533 PIN# ~~4636307807~~ 4636-30-7956 DATE March 26, '99

OWNER OR CONTRACTOR M.T. Fox & Assoc. PHONE: Business Home

ADDRESS 8537 S. Tryon Charlotte

LOCATION Crawley Sch Rd To Glade of Pines TL Garnet Drive TL 1st Street on Right

SUBDIVISION Lakeview Heights BLOCK / SECTION LOT 16 LOT AREA .69 Ac SITE CLASS V5 DESIGN FLOW 360 gpd L.T.A.R. .3

Septic Tank: 1000 Gallons; STB 312 Date 5/7/99
Pump Tank: Gallons; PT Date
Pump Make: Model Serial No.
Nitrification Field: No Fields 1 Square Feet 900 Linear Feet 300
No Lines 3@100' Trench Width 36" Max Trench Bottom Depth 36" Gravel Depth N/A

☑ New System ☐ Repair System Type: I, II, III, IV, V, VI
System Description: Gravity Innovative 25% Reduction
Repair System Description: 2 Panel Block Trench
Maintenance Agreement Required: ☐ Yes ☑ No


☑ House/Mod. Home No. Bedrooms 3
☐ Mobile Home No. Bathrooms 2½
☐ Business No. Employees
☐ Other
☐ Slab ☑ Crawl Space ☐ Basement w/plumbing ☐ Basement wo/plumbing

Water Supply: ☑ Individual ☐ Public ☐ Community

Comments:/Conditions: * ONE INSPECTION PORT PER LATERAL

Comments:/Conditions:

1"=50' INITIAL SITE SKETCH

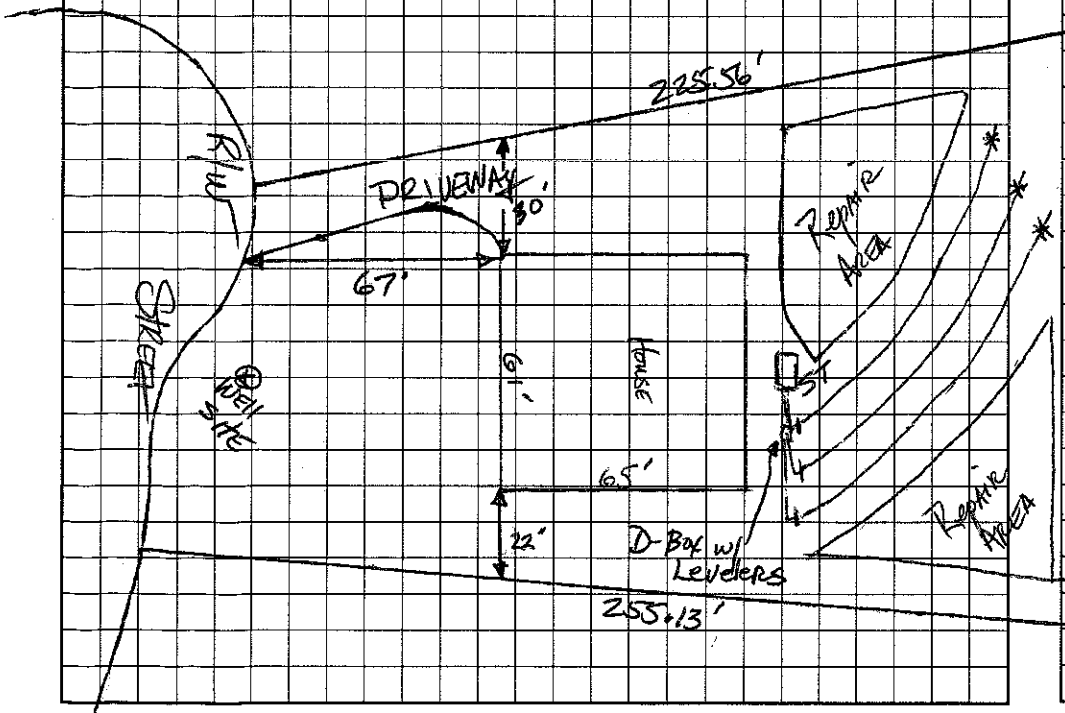

AS BUILT SKETCH

Permit can be suspended or revoked if any false information is supplied toward securing the permit/any unauthorized changes are made to the site/any unauthorized changes are made in the installation of the system. Improvement Permit with plat valid without expiration. Improvement Permit with site plan valid for sixty months. Authorization to Construct is valid for a period equal to that of Improvement Permit – not to exceed sixty months.

Signed: date 3-29-99 Installed by: Kurt Dunning

Improvement Permit by: date 3-26-99 Operation Permit by: RS date 5/5/99

Authorization to Construct by: date 3-26-99 Existing System Inspection by: date

HEALTH DEPT. COPY: WHITE OWNER COPY (FINAL): YELLOW OWNER COPY (INITIAL): PINK