IREDELL COUNTY HEALTH DEPARTMENT - *ENVIRONMENTAL HEALTH* ☐ STATESVILLE OFFICE 704-878-5305 ☑ MOORESVILLE OFFICE 704-664-5281

IMPROVEMENT PERMIT / AUTHORIZATION TO CONSTRUCT / OPERATION PERMIT / EXISTING SYSTEM INSPECTION

PERMIT # 168940 PIN # 4636-30-9577 DATE 11-29-11

OWNER RACE CITY RENTALS APPLICANT: SAME PHONE: Home/Cell # 704-881-2957 Business #

SITE ADDRESS 193 GANNETT DR. OWNER / APPLICANT ADDRESS

SITE DIRECTIONS BSR, ISLE OF PINES, GANNETT, ON (L)

SUBDIVISION LAKEVIEW HEIGHTS BLOCK / SECTION LOT # 60 LOT AREA .69AC DESIGN FLOW 480 GAL/DAY L.T.A.R. .3

Septic Tank 1000 Gallons: STB 796 Date 5-24-13
Pump Tank Gallons: P T Date
Pump Make Model Serial #
No. Nitrification Fields: 1 No. Lines 6 Linear Feet 405'
Trench Width 36" Max. Trench Bottom Depth 36" Gravel Depth —


☑ New System ☐ Repair ☐ Expansion System Type I II (III) IV V VI
System Description: G-25% RED
Repair System Description: PM-25% RED
Maintenance Agreement Required ☐ YES ☒ NO
☒ GRAVITY ☐ PRESSURE

☒ Residence No. Bedrooms 4
☐ Business No. Persons
☐ Other No. Employees
☐ Slab ☒ Crawl Space
☐ Basement w/plumbing ☐ Basement w/o plumbing


Water Supply: ☒ Private ☐ Public ☐ Community

Comments / Conditions

INITIAL SITE SKETCH

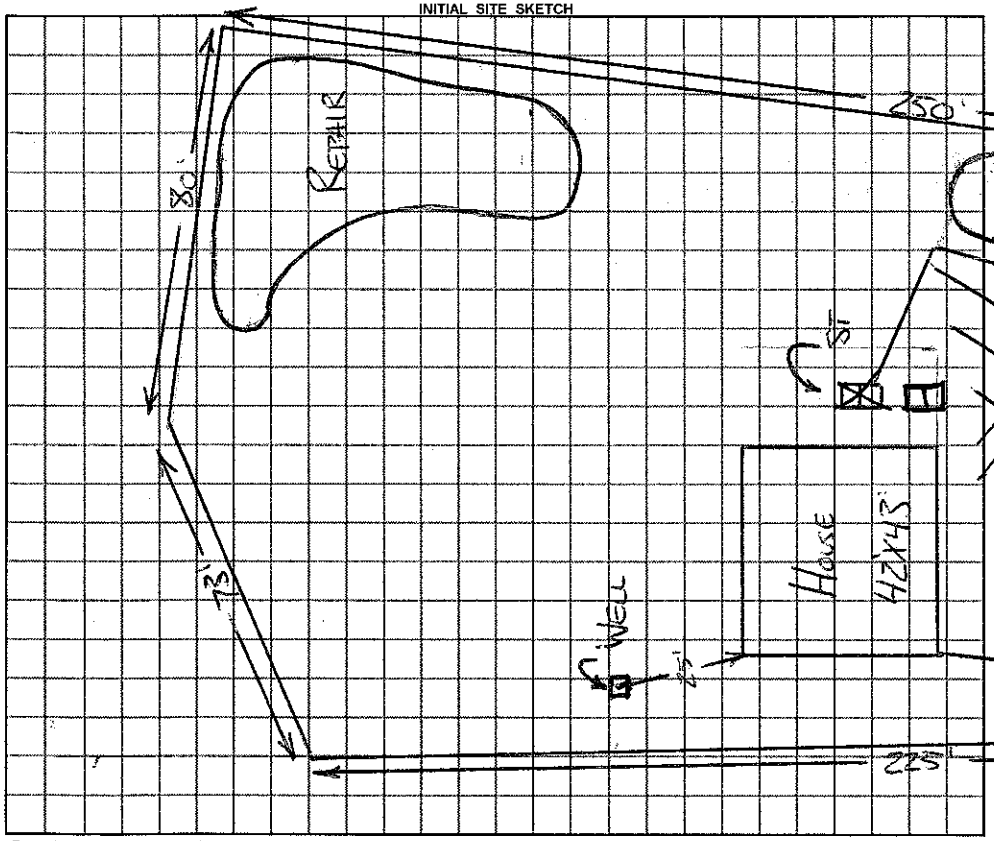

AS BUILT SKETCH

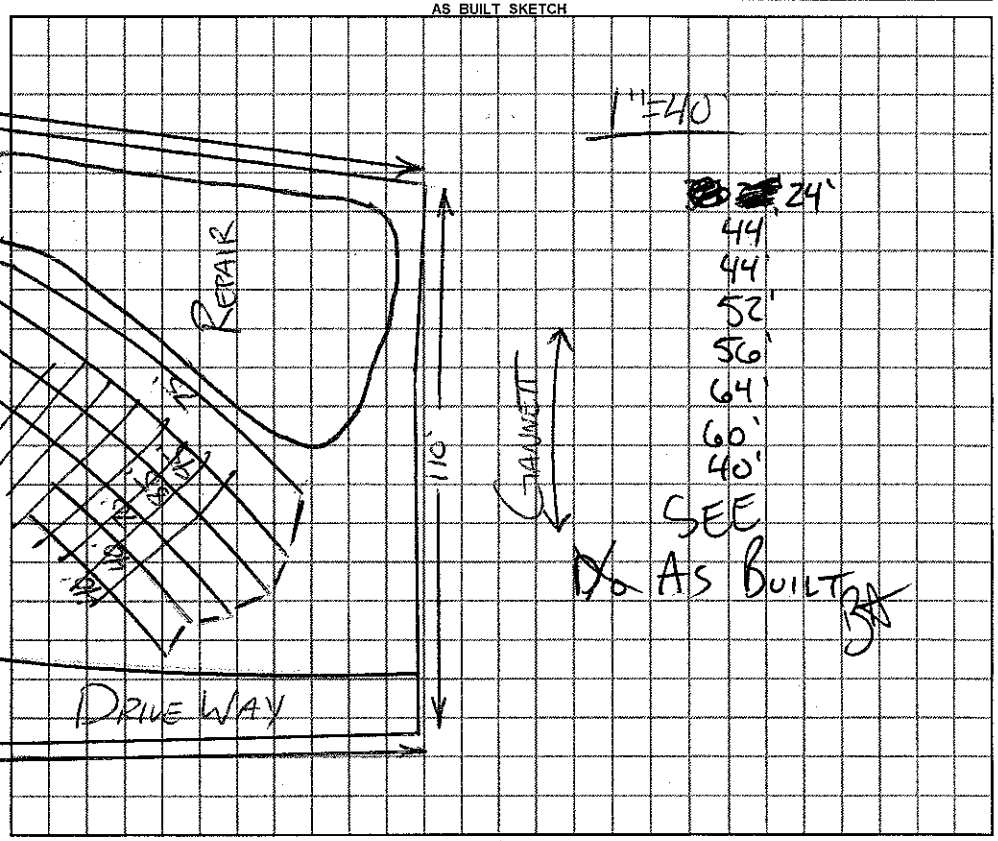

Permit can be suspended or revoked if any false information is supplied toward securing the permit / any unauthorized changes are made to the site / any unauthorized changes are made in the installation of the system.

☐ ***IMPROVEMENT PERMIT*** with plat valid ~~without expiration~~. ☐ ***IMPROVEMENT PERMIT*** with ~~plat valid without expiration~~. site plan valid 60 mo. ☑ ***AUTHORIZATION TO CONSTRUCT*** valid for period equal to IMPROVEMENT PERMIT--not to exceed 60 mo.

Owner / Applicant Signature: Date

IMPROVEMENT PERMIT by: REHS Date 11-29-11

AUTHORIZATION TO CONSTRUCT by: REHS Date 11-29-11

YOU SHOULD CONTACT A LOCATOR SERVICE PRIOR TO ANY EXCAVATION

Installed by: ABEGNATHY

OPERATION PERMIT by: REHS Date 10-23-13

Existing System Inspected by: REHS Date

White Copy – Environmental Health YELLOW COPY (Final) Owner / Applicant PINK COPY (Initial) Owner / Applicant