
As Built Not To Scale

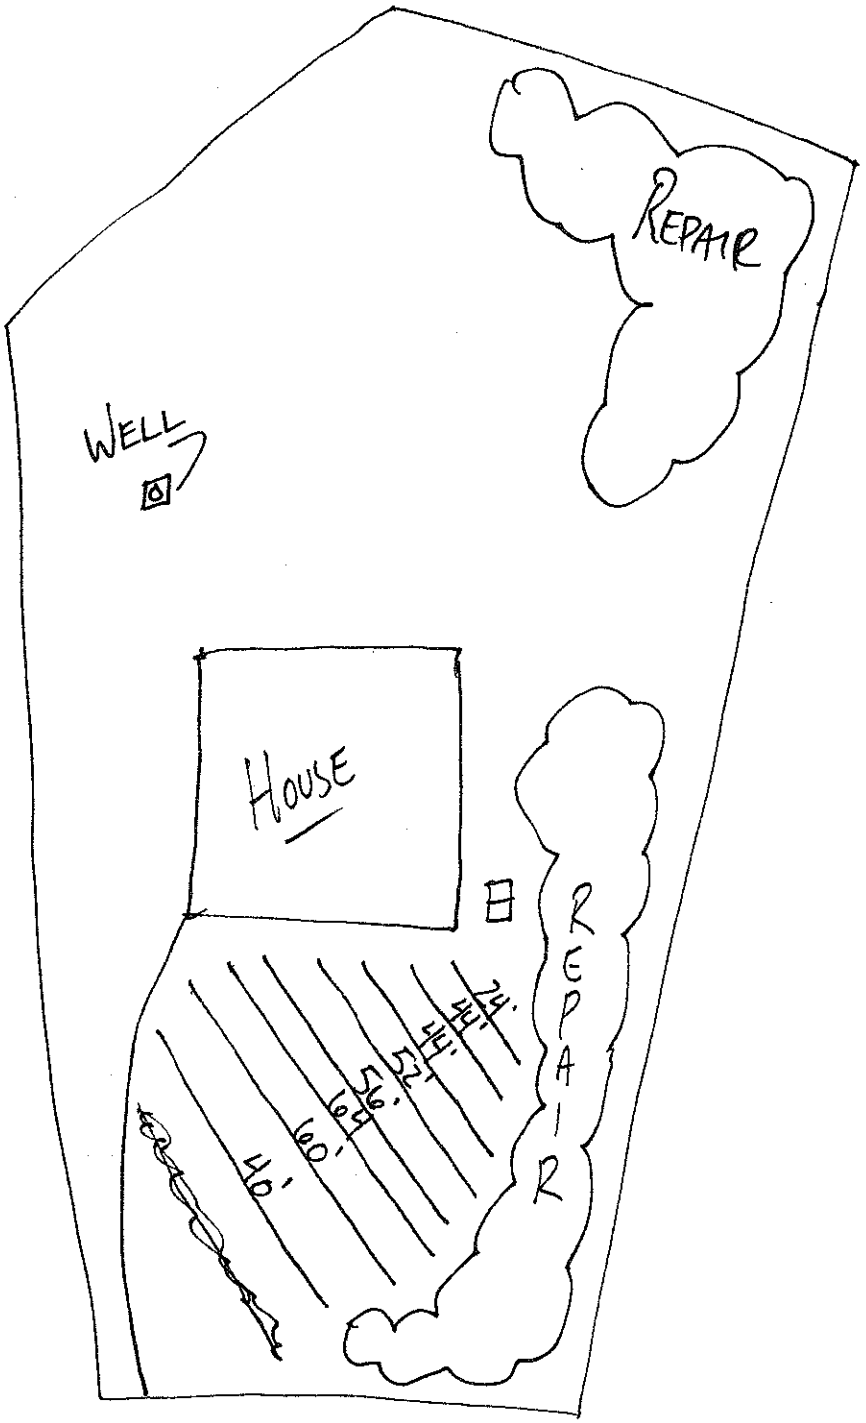

GANNETT