IREDELL COUNTY HEALTH DEPARTMENT

STATESVILLE 704-878-5305 MOORESVILLE 704-664-5281

$ 155

IMPROVEMENT PERMIT / AUTHORIZATION TO CONSTRUCT / OPERATION PERMIT / EXISTING SYSTEM INSPECTION

PERMIT# 075161 PIN# 4636078807 4636-30-9881 DATE March 6, 03

OWNER OR CONTRACTOR Glen Edwards Const Inc PHONE: Business (704) 363-3713 Home

ADDRESS 2419 Harvey Bowman Rd. Monroe, N.C. 28110

LOCATION Brantley Sch Rd. TL Isle of Pines TL Gamlet on left after sharp curve # 203 Gamlet Dr.

SUBDIVISION Lakeland Heights BLOCK / SECTION LOT 4 LOT AREA 1.69 Ac SITE CLASS. PS DESIGN FLOW 440 gpd L.T.A.R. .3

Septic Tank: 1000 Gallons; STB 794 Date 7-15-03

Pump Tank: 1000 Gallons; PT 283 Date 7-21-03

Pump Make: Gould's Model Serial No.

Nitrification Field: No Fields 1 Square Feet 1200 Linear Feet 400

No Lines 4 Trench Width 36" Max Trench Bottom Depth 36" Gravel Depth N/A

☑ New System ☐ Repair System Type: I, II, (III), IV, V, VI

System Description: PM 25% Reduction

Repair System Description: LPP PMPS

Maintenance Agreement Required: ☐ Yes ☑ No, initially

☑ House/Mod. Home No. Bedrooms 4

☐ Mobile Home No. Bathrooms 3

☐ Business No. Employees

☐ Other

☐ Slab ☑ Crawl Space ☐ Basement w/plumbing ☐ Basement wo/plumbing


Water Supply: ☑ Individual ☐ Public ☐ Community

Comments/Conditions: 4/22/03 okay to move tanks to other side of house towards back.

Comments/Conditions: Checked Upper 3 lines 9/2/03

4th line Checked 9/3/03

INITIAL SITE SKETCH 1"=50'

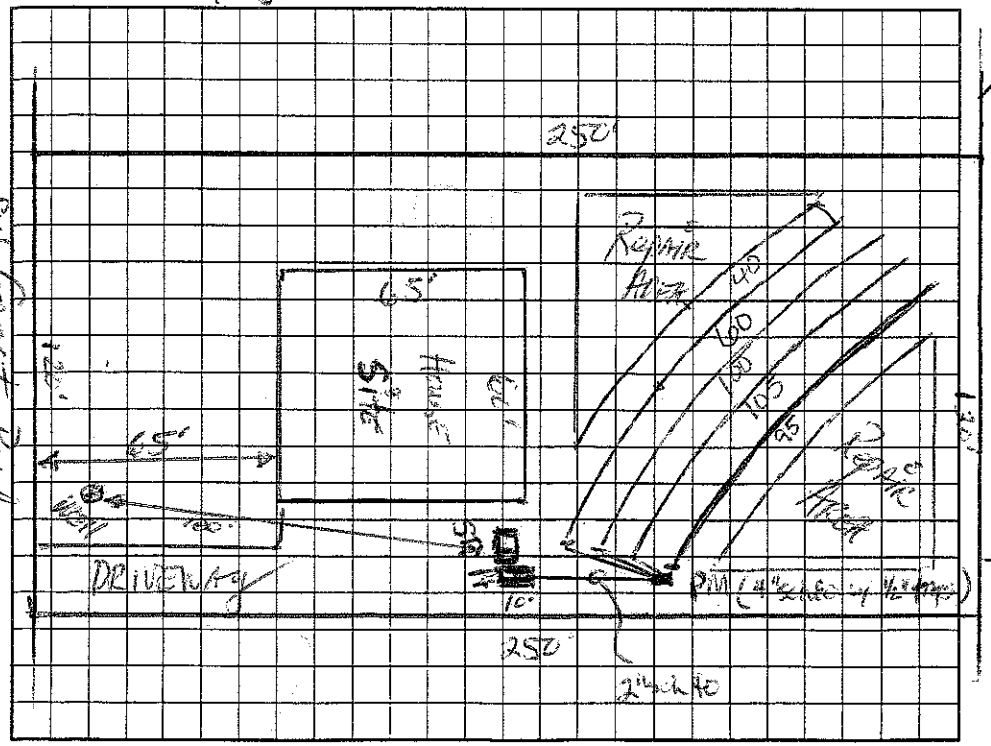

AS BUILT SKETCH

Permit can be suspended or revoked if any false information is supplied toward securing the permit/any unauthorized changes are made to the site/any unauthorized changes are made in the installation of the system. Improvement Permit with plat valid without expiration. Improvement Permit with site plan valid for sixty months. Authorization to Construct is valid for a period equal to that of Improvement Permit – not to exceed sixty months.

Signed: W S Edwards date

Installed by: Marty Tucker

Improvement Permit by: Mickey D. Hinson, RS date 3-6-03

Operation Permit by: [signature] RS date 1/14/04

Authorization to Construct by: Mickey D. Hinson, RS date 3-6-03

Existing System Inspection by: date

HEALTH DEPT. COPY: WHITE OWNER COPY (FINAL): YELLOW OWNER COPY (INITIAL): PINK