3.30

IREDELL COUNTY HEALTH DEPARTMENT

STATESVILLE 704-878-5305 MOORESVILLE 704-664-5281

IMPROVEMENT PERMIT / AUTHORIZATION TO CONSTRUCT / OPERATION PERMIT / EXISTING SYSTEM INSPECTION

PERMIT# 074589 PIN# 4636307807 pt 4636311093 DATE

OWNER OR CONTRACTOR MIKE FOX PHONE: Business Home

ADDRESS 8537 S. TRYON ST CHARLOTTE NC 28373

LOCATION BRAWLEY SCHOOL RD - TL ISLE OF PINES - ON CORNER OF GANNETT DR.

SUBDIVISION LAKE VIEW HEIGHTS BLOCK / SECTION LOT 23 LOT AREA SITE CLASS. PS DESIGN FLOW 360 GPD L.T.A.R. .30 GPD/FT²

Septic Tank: 1000 Gallons; STB 1812 Date 10/23/98

Pump Tank: 1000 Gallons; PT 47 Date 10/2/98

Pump Make: MEYERS Model ME40 Serial No.

Nitrification Field: No Fields 1 Square Feet 900 Linear Feet 300

No Lines 5 @ 60' Trench Width 36" Max Trench Bottom Depth 36" Gravel Depth N/A

☑ New System ☐ Repair System Type: I, II, III, IV, V, VI

System Description: PUMP CHAMBER OR HDS

Repair System Description: PUMP PANEL

Maintenance Agreement Required: ☐ Yes ☑ No

☑ House/Mod. Home No. Bedrooms 3

☐ Mobile Home No. Bathrooms 2

☐ Business No. Employees

☐ Other


☐ Slab ☑ Crawl Space ☐ Basement w/plumbing ☐ Basement wo/plumbing

Water Supply: ☑ Individual ☐ Public ☐ Community

Comments:/Conditions:

Comments:/Conditions:

INITIAL SITE SKETCH 1"=60'

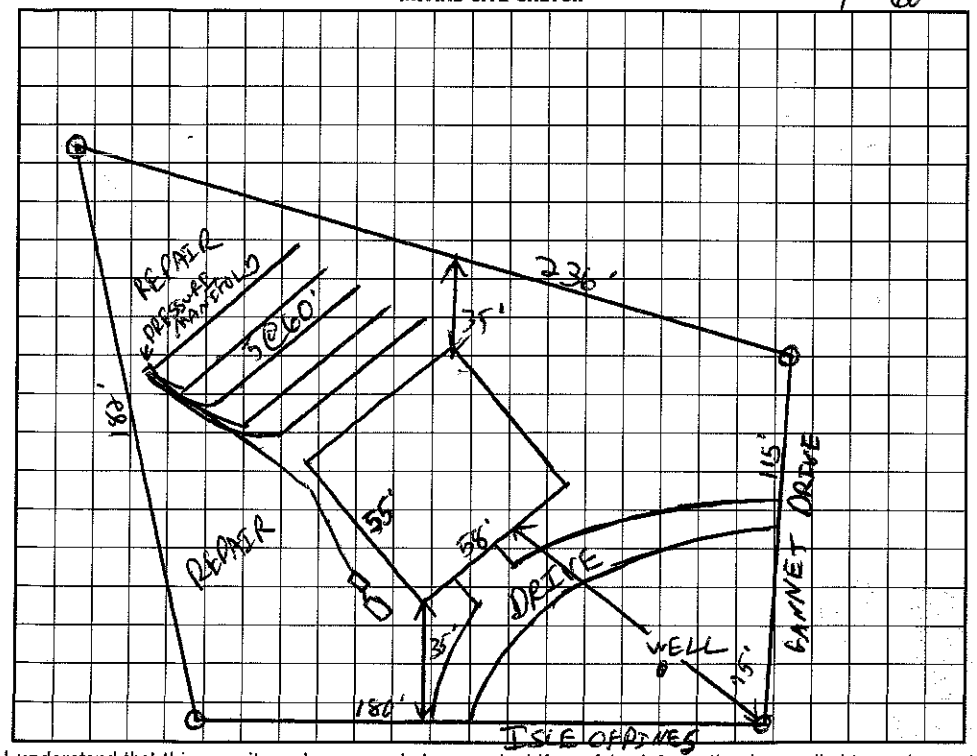

AS BUILT SKETCH

I understand that this permit can be suspended or revoked if any false information is supplied toward securing the permit/any unauthorized changes are made to the site/any unauthorized changes are made in the installation of the system. Improvement Permit with plat valid without expiration. Improvement Permit with site plan valid for sixty months. Authorization to Construct is valid for a period equal to that of Improvement Permit – not to exceed sixty months.

Signed: L. Shawn Ogden date 7-29-98 Installed by: Richard Abernathy

Improvement Permit by: C. Bryan Lee RS date 7/29/98 Operation Permit by: Wesley Sparks RS date 4/1/99

Authorization to Construct by: C. Bryan Lee RS date 7/29/98 Existing System Inspection by: date

HEALTH DEPT. COPY: WHITE INSPECTION COPY (FINAL): GREEN OWNER COPY (FINAL): YELLOW INSPECTION COPY (INITIAL): PINK OWNER COPY (INITIAL): GOLD