158530 4636313881 3:30

IREDELL COUNTY HEALTH DEPARTMENT

STATESVILLE 704-878-5305 MOORESVILLE 704-664-5281

IMPROVEMENT PERMIT / AUTHORIZATION TO CONSTRUCT / OPERATION PERMIT / EXISTING SYSTEM INSPECTION

PERMIT # 122298 PIN # 4636328692.049 DATE 9-29-09

OWNER or APPLICANT Orleans Homes PHONE: Business Rich Howard 980 721-8824 Home:

OWNER or APPLICANT ADDRESS 700 Forest Pt. Circle Charlotte, NC 28273

LOCATION / DIRECTIONS Brawley School Rd TL Isle of Pines TL Isle Run Dr. 1st lot on left

SUBDIVISION The Cove @ Chesapk Pt. BLOCK / SECTION LOT # 49 LOT AREA .69 DESIGN FLOW 480gpd L.T.A.R. .3

Septic Tank 1000 Gallons: STB 312 Date 12-28-10 ☒ New System ☐ Repair ☐ Expansion System Type I II III IV V VI

Pump Tank 1000 Gallons: PT 283 Date 11-14-10 System Description: Pump-LP-Panel Blk.

Pump Make Hydramatic Model Serial # Repair System Description: Same

Nitrification Field No Fields 1 No Lines 3 Linear Feet 270' Maintenance Agreement Required ☒ YES ☐ NO

Trench Width min 24" Max. Trench Bottom Depth 36" Gravel Depth N/A ☐ GRAVITY ☒ PRESSURE


☒ Residence No. Bedrooms 4 ☐ Business No. Persons ☐ Other No. Employees ☐ Slab ☐ Crawl Space ☐ Basement w/plumbing ☐ Basement w/o plumbing

Water Supply: ☐ Private ☒ Public ☒ Community

Comments / Conditions: Keep Septic 10ft From PL

Comments / Conditions: Note: Any Future pool must be at least 15ft from Septic. 2/15/11 Tanks, lines & pressure 3 1/2" hdr.

INITIAL SITE SKETCH

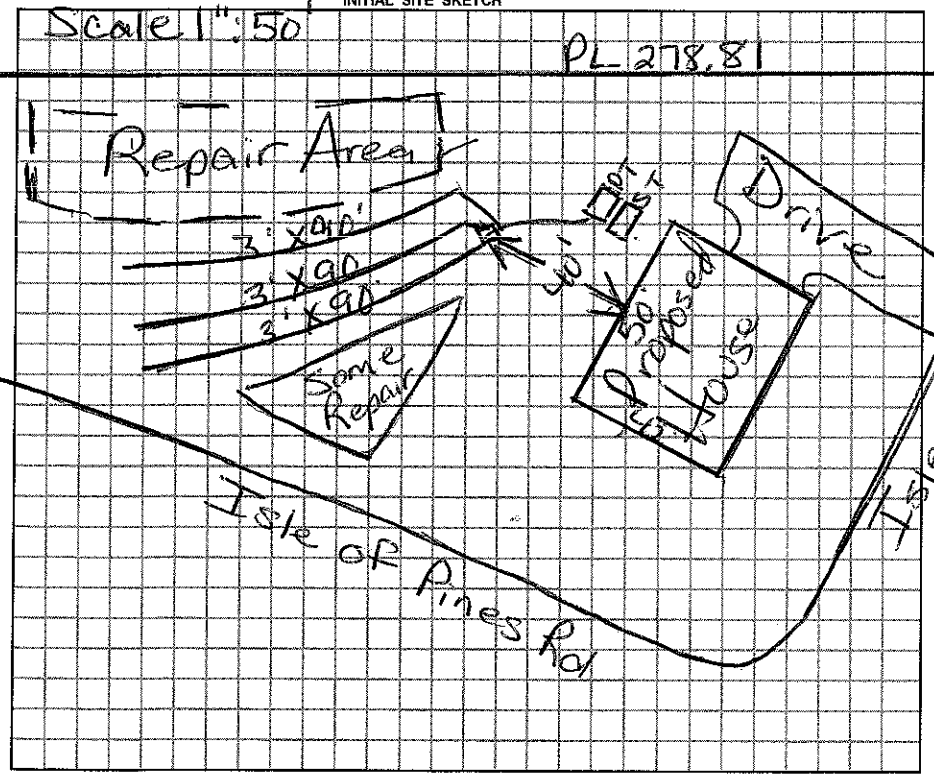

AS BUILT SKETCH

Installed As Drawn

Permit can be suspended or revoked if any false information is supplied toward securing the permit / any unauthorized changes are made to the site / any unauthorized changes are made in the installation of the system.

☐ *IMPROVEMENT PERMIT w / plat valid without expiration* ☐ *IMPROVEMENT PERMIT w / site plan valid for 60 mos.* ☐ *AUTHORIZATION TO CONSTRUCT valid for period equal to IMPROVEMENT PERMIT-not to exceed 60 mo.*

Owner / Applicant Signature: Date

Improvement Permit by: Maina Dotson RS Date 9/29/09

Authorzation to Construct by: Maina Dotson RS Date 9/29/09

Installed by: Willie Christenbury

Operation Permit by: Maina Dotson RS Date: 3/15/11

Existing System Inspected by Date:

YOU SHOULD CONTACT A LOCATOR SERVICE PRIOR TO ANY EXCAVATION.

WHITE COPY Environmental Health YELLOW COPY (Final) Owner / Applicant PINK COPY (Initial) Owner / Applicant