IREDELL COUNTY HEALTH DEPARTMENT

STATESVILLE 704-878-5305 MOORESVILLE 704-664-5281

IMPROVEMENT PERMIT / AUTHORIZATION TO CONSTRUCT / OPERATION PERMIT / EXISTING SYSTEM INSPECTION

PERMIT# 121282 PIN# ~~4636-37-8692.000~~ 4636-31-4521 DATE Sept 27 04

OWNER OR CONTRACTOR Quest Enterprises (Pine Isle, LLC) / Orders PHONE: Business Home

ADDRESS 125 Easton Dr. Mooresville, N.C. 28117

LOCATION Brawley Sch Rd TL Isle of Pines TL Isle Run DR. 2nd lot on Right

SUBDIVISION The Cove at Chesapeake PH BLOCK / SECTION LOT 2 LOT AREA ± .76 ac SITE CLASS. PS DESIGN FLOW 480 gpd L.T.A.R. ± 3

Septic Tank: 1000 Gallons; STB 312 Date 5-4-07
Pump Tank: Gallons; PT Date
Pump Make: Model Serial No.
Nitrification Field: No. Fields 1 Square Feet 1200 Linear Feet 400
No Lines 5 @ 80 Trench Width 36" Max Trench Bottom Depth 36"

☑ New System ☐ Repair System Type: I II III IV V VI
System Description: ~~Gravity~~ 25% Reduction
Repair System Description: Gravity/pumped 25% Red.
Maintenance Agreement Required: ☐ Yes ☒ No

~~☐ House/Mod. Home~~ No. Bedrooms 4
☐ Mobile Home No. Bathrooms
☐ Business No. Employees
☐ Other

Water Supply: ☐ Individual ~~☑ Public~~ ☐ ~~Community~~


Gravel Depth N/A ☐ Slab ☑ Crawl Space ☐ Basement w/plumbing ☐ Basement wo/plumbing

Comments:/Conditions:
Plumbing must exit within 6" of Excavated at tank location. Do Not cut/Lower Raised Site!


Comments:/Conditions:
Installed E-Z Flow on "Drop boxes" as Drawn

1"=50'

INITIAL SITE SKETCH

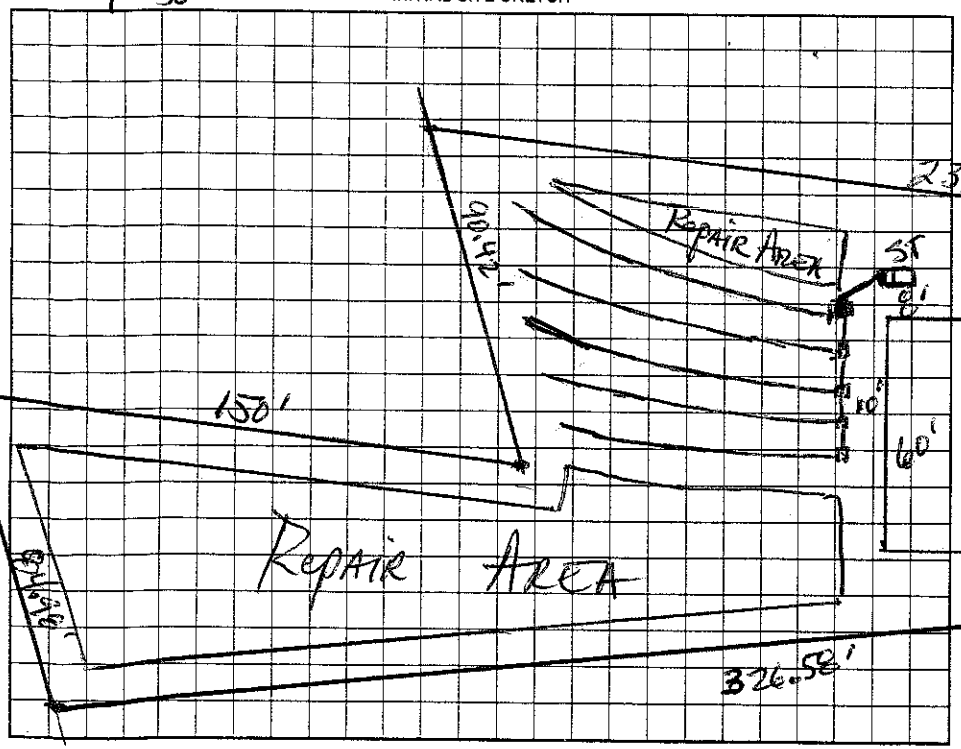

AS BUILT SKETCH

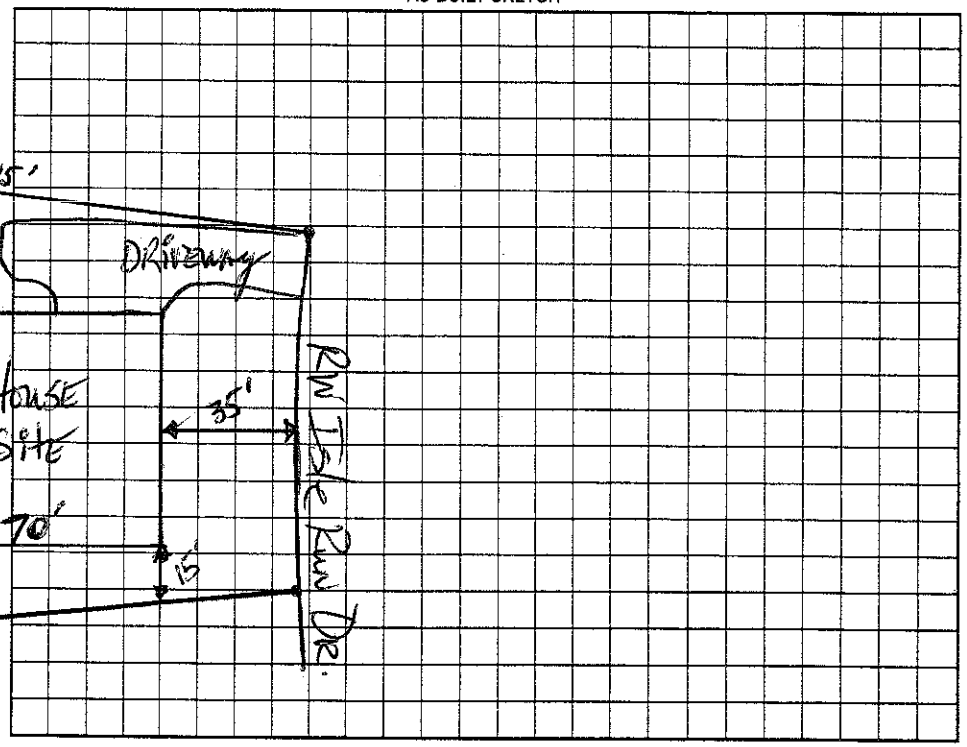

Permit can be suspended or revoked if any false information is supplied toward securing the permit/any unauthorized changes are made to the site/any unauthorized changes are made in the installation of the system. Improvement Permit with plat valid without expiration. Improvement Permit with site plan valid for sixty months. Authorization to Construct is valid for a period equal to that of Improvement Permit – not to exceed sixty months.

Signed: R.B. Rochelle date 10/28/04

Improvement Permit by: date 9-27-04

Authorization to Construct by: date 4-12-07

Installed by: Willie Christenbury

Operation Permit by: Maria H. Dotson date 10/10/07

Existing System Inspection by: date

HEALTH DEPT. COPY: WHITE OWNER COPY (FINAL): YELLOW OWNER COPY (INITIAL): PINK