IREDELL COUNTY HEALTH DEPARTMENT

STATESVILLE 704-878-5305 #155 MOORESVILLE 704-664-5281

IMPROVEMENT PERMIT / AUTHORIZATION TO CONSTRUCT / OPERATION PERMIT / EXISTING SYSTEM INSPECTION

PERMIT# 075534 PIN# ~~4636 30 7807~~ 4636-31-5270 DATE 3/13/03

OWNER OR CONTRACTOR The Dupont Group Inc. PHONE: Business 704 660-0402 Home

ADDRESS 110 Charleston Dr. Suite 108 Mooresville NC 28117

LOCATION Brawley Sch, TL Isle of Pines, TL Garnet, TL Barton Pl, at end

SUBDIVISION Lakeview Hts. BLOCK / SECTION LOT 19 LOT AREA 30,940 ft² SITE CLASS. 05 DESIGN FLOW 480 L.T.A.R. 0.5

Septic Tank: 1000 Gallons; STB 312 Date 8-22-03
Pump Tank: Gallons; PT Date
Pump Make: Model Serial No.
Nitrification Field: No Fields 1 Square Feet 1200 Linear Feet 400'
No Lines 5 of 5 Trench Width 36" Max Trench Bottom Depth 36" Gravel Depth —

☒ New System ☐ Repair System Type: I, II, (III), IV, V, VI
System Description: Gravity 25% Reduction
Repair System Description: Same
Maintenance Agreement Required: ☐ Yes ☒ No

☒ House/Mod. Home No. Bedrooms 4
☐ Mobile Home No. Bathrooms 3
☐ Business No. Employees
☐ Other
☐ Slab ☒ Crawl Space ☐ Basement w/plumbing ☐ Basement wo/plumbing


Water Supply: ☒ Individual ☐ Public ☐ Community

Comments:/Conditions:


1" = 50'

Comments:/Conditions:
Checked tank 9/25/03
Checked 4 of 5 lines 10/13/03
Checked 5th line & D-box 10/14/03

INITIAL SITE SKETCH

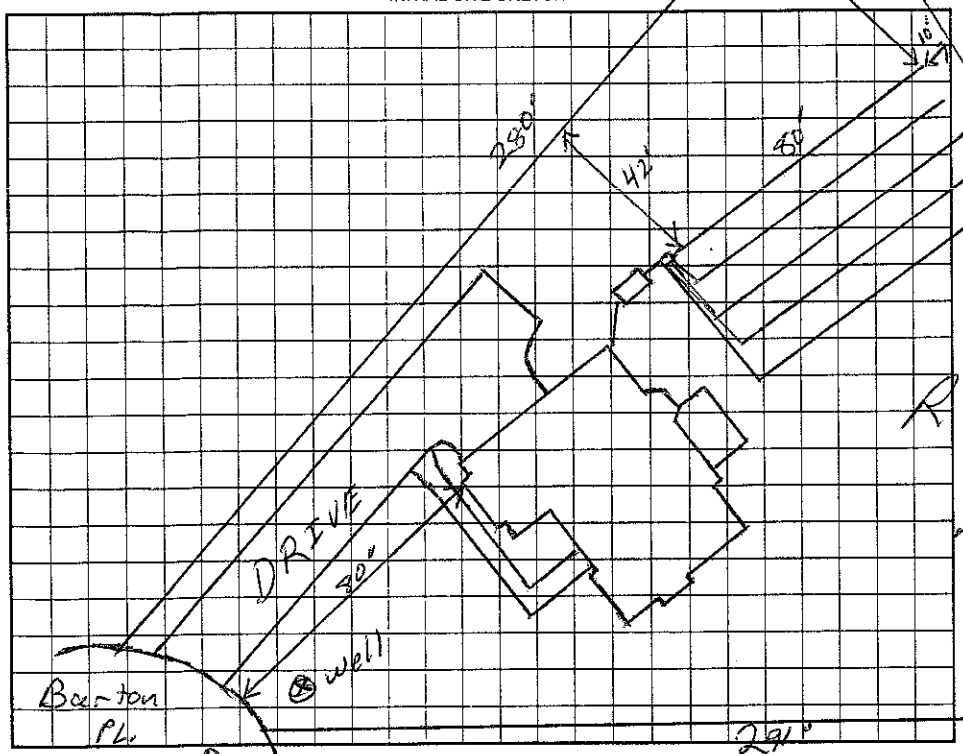

AS BUILT SKETCH

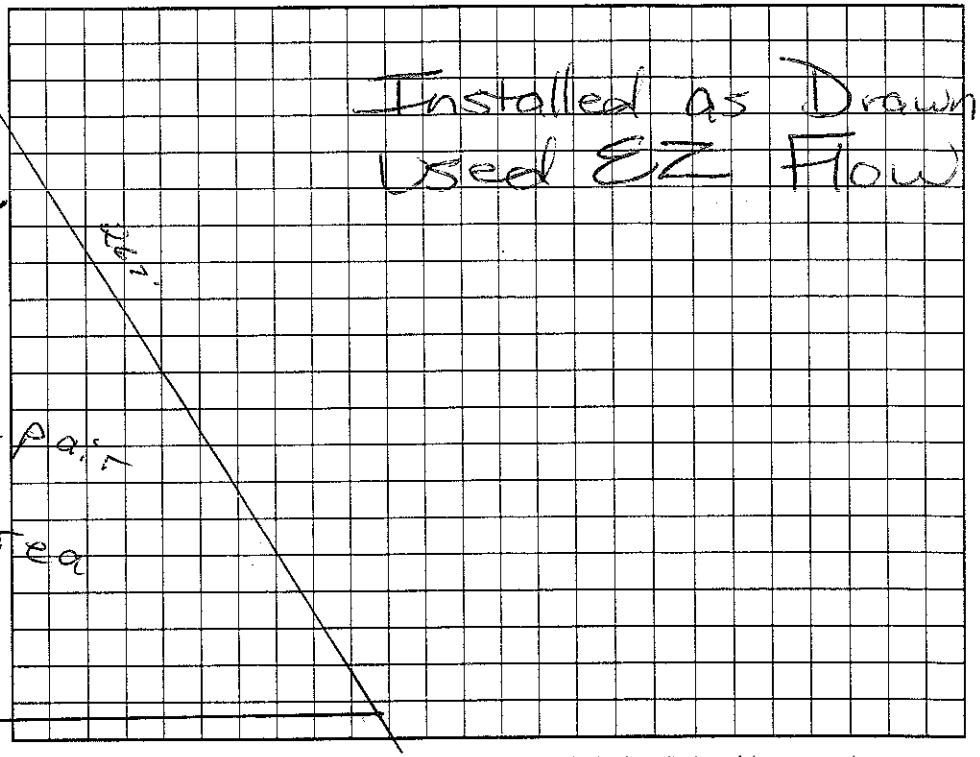

Permit can be suspended or revoked if any false information is supplied toward securing the permit/any unauthorized changes are made to the site/any unauthorized changes are made in the installation of the system. Improvement Permit with plat valid without expiration. Improvement Permit with site plan valid for sixty months. Authorization to Construct is valid for a period equal to that of Improvement Permit – not to exceed sixty months.

Signed: date

Improvement Permit by: RS date 3/13/03

Authorization to Construct by: RS date 3/13/03

Installed by: R & H Inc. RS

Operation Permit by: Maria H. Dotson date 10/14/03

Existing System Inspection by: date

HEALTH DEPT. COPY: WHITE OWNER COPY (FINAL): YELLOW OWNER COPY (INITIAL): PINK