IREDELL COUNTY HEALTH DEPARTMENT

STATESVILLE 704-878-5305 MOORESVILLE 704-664-5281

3.00

IMPROVEMENT PERMIT / AUTHORIZATION TO CONSTRUCT / OPERATION PERMIT / EXISTING SYSTEM INSPECTION

PERMIT# 122295 PIN# ~~4636-32-8692.047~~ (PINE ISLE LLC) / Robert Ervin 4636 315 883 DATE Oct. 21, 04

OWNER OR CONTRACTOR Dienst Enterprises PHONE: Business _____ Home _____

ADDRESS 125 Easton Dr, Mooresville, N.C. 28117

LOCATION Brawley Sch Rd. TL Isle of Pines TL Isle Rue Dr. 3rd lot on left

SUBDIVISION The Cove at Chesapeake Pt. BLOCK / SECTION _____ LOT 47 LOT AREA .70Ac SITE CLASS. PS DESIGN FLOW 480gpd L.T.A.R. .3

Septic Tank: 1000 Gallons; STB 312 Date 8-20-05

Pump Tank: 1000 Gallons; PT 283 Date 10-1-05

Pump Make: Myers Model ME50SH Serial No. _____

Nitrification Field: ~~No~~ Fields 1 Square Feet 540/810 Linear Feet 270

No Lines 3 Trench Width 24" min 8'o c-Max Trench Bottom Depth 36" Gravel Depth N/A

☑ New System ☐ Repair System Type: I, II, III, IV, V, VI

System Description: LPPPBPS

Repair System Description: LPPPBPS

Maintenance Agreement Required: ☑ Yes ☐ No

~~☐~~ House/Mod. Home No. Bedrooms 4

☐ Mobile Home No. Bathrooms _____

☐ Business No. Employees _____

☐ Other _____


☐ Slab ~~☑~~ Crawl Space ☐ Basement w/plumbing ☐ Basement wo/plumbing

Water Supply: ☐ Individual ~~☑~~ Public ~~☐~~ Community


Comments/Conditions: OR = 36" min 9'oc

Comments/Conditions: Tanks, lines & pressure checked 3/14/06 MO
Note Final grading not done at time of O.P. Inspection: must keep PT riser 6 inches above grade & NEMA4X box 12 inches above grade.

1"=50' INITIAL SITE SKETCH

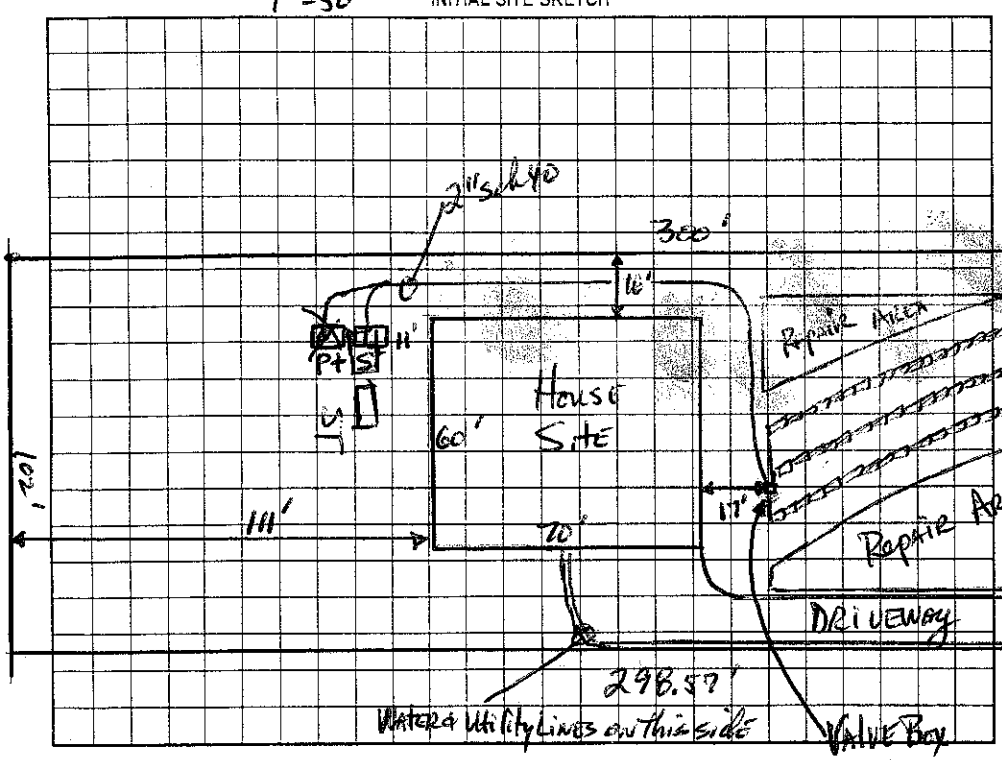

AS BUILT SKETCH

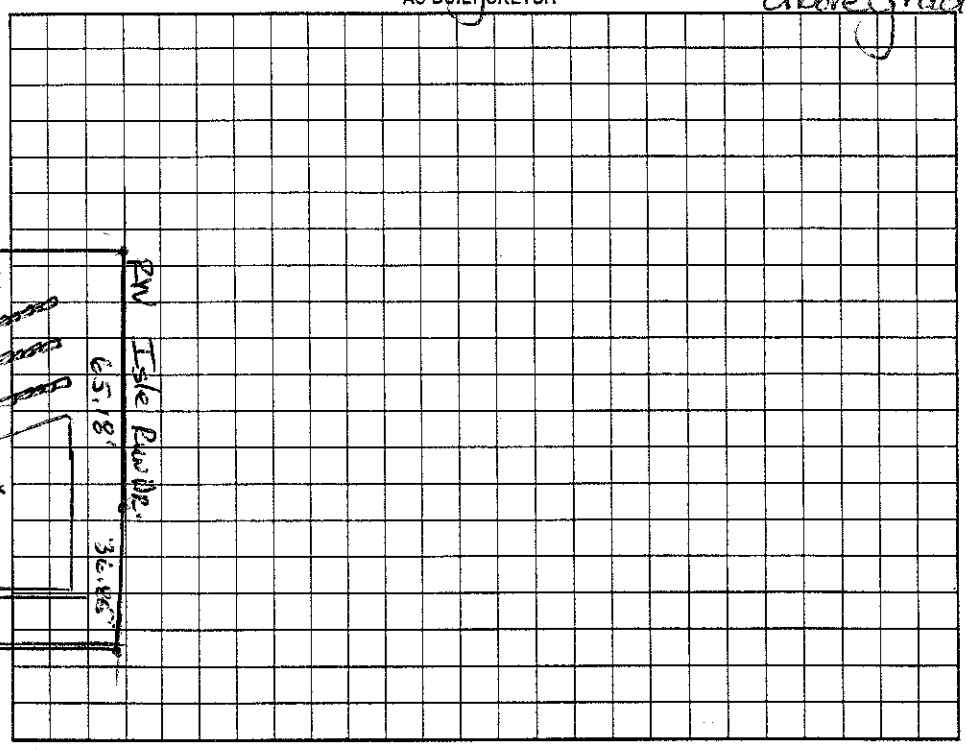

Permit can be suspended or revoked if any false information is supplied toward securing the permit/any unauthorized changes are made to the site/any unauthorized changes are made in the installation of the system. Improvement Permit with plat valid without expiration. Improvement Permit with site plan valid for sixty months. Authorization to Construct is valid for a period equal to that of Improvement Permit – not to exceed sixty months.

Signed: _____ date 10.26.04 Installed by: Willie Christenbury

Improvement Permit by: _____ date 10-21-04 Operation Permit by: _____ date 9/1/06

Authorization to Construct by: _____ date 10/7/05 Existing System Inspection by: _____ date _____

HEALTH DEPT. COPY: WHITE OWNER COPY (FINAL): YELLOW OWNER COPY (INITIAL): PINK