IREDELL COUNTY HEALTH DEPARTMENT

STATESVILLE 704-878-5305 (10:30) MOORESVILLE 704-664-5281 (1:30)

IMPROVEMENT PERMIT / AUTHORIZATION TO CONSTRUCT / OPERATION PERMIT / EXISTING SYSTEM INSPECTION

PERMIT# 075536 PIN# ~~4636307807~~ 4636-31-7058 DATE March 26 '99

OWNER OR CONTRACTOR M.J. Fox & Assoc. PHONE: Business Home

ADDRESS 5537 S. Tryon Charlotte

LOCATION Beaverdam Rd. TL Lake of Pines TL Gannet TL 1st Street on Right in cul-de-sac

SUBDIVISION Lakeview Heights BLOCK / SECTION LOT 17 LOT AREA .74Ac SITE CLASS. PS DESIGN FLOW 360gpd L.T.A.R. .3

Septic Tank: 1000 Gallons; STB 1012 Date 6/30/99

Pump Tank: Gallons; PT Date

Pump Make: Model Serial No.

Nitrification Field: No Fields 1 Square Feet 1200 Linear Feet 400

No Lines 5@80' Trench Width 36" Max Trench Bottom Depth 36" Gravel Depth 12"

☑ New System ☐ Repair System Type: I, II, III, IV, V, VI

System Description: Gravity Conventional

Repair System Description: Gravity/Pumped Innovative

Maintenance Agreement Required: ☐ Yes ☑ No

☑ House/Mod. Home ☐ Mobile Home ☐ Business ☐ Other

No. Bedrooms 3 No. Bathrooms 2½ No. Employees


☐ Slab ☑ Crawl Space ☐ Basement w/plumbing ☐ Basement wo/plumbing

Water Supply: ☑ Individual ☐ Public ☐ Community

Comments:/Conditions:

Comments:/Conditions:

1"=50' INITIAL SITE SKETCH

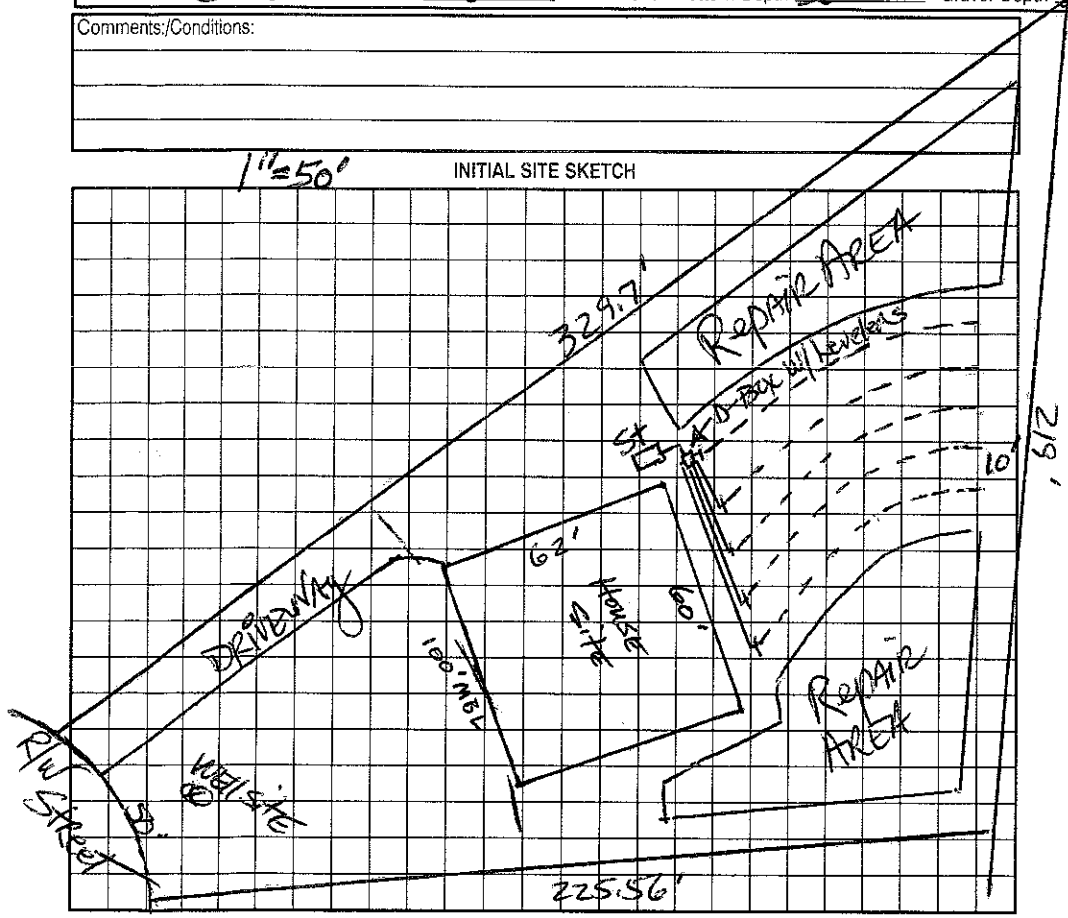

AS BUILT SKETCH

Permit can be suspended or revoked if any false information is supplied toward securing the permit/any unauthorized changes are made to the site/any unauthorized changes are made in the installation of the system. Improvement Permit with plat valid without expiration. Improvement Permit with site plan valid for sixty months. Authorization to Construct is valid for a period equal to that of Improvement Permit – not to exceed sixty months.

Signed: [signature] date 3-29-99 Installed by: Richard Abernathy

Improvement Permit by: [signature] date 3-26-99 Operation Permit by: Wesley Sparks R.S. date 9/16/99

Authorization to Construct by: [signature] date 3-26-99 Existing System Inspection by: date

HEALTH DEPT. COPY: WHITE OWNER COPY (FINAL): YELLOW OWNER COPY (INITIAL): PINK