IREDELL COUNTY HEALTH DEPARTMENT

Statesville Office (704) 878-5305 Mooresville Office (704) 660-3625 PERMIT # 203174

IMPROVEMENT PERMIT / AUTHORIZATION TO CONSTRUCT / OPERATION PERMIT / EXISTING SYSTEM

PIN # 4636-32-1814

APPLICANT: TAYLOR MADE CUSTOM HOMES APPLICANT ADDRESS: 403 GILEAD RD. STE. 11 HUNTERSVILLE NC

SITE ADDRESS: 108 MEADOW CREST MOORESVILLE NC PHONE: ALT. PHONE:

SITE DIRECTIONS: BSR, TL ISLE OF PINES, TL MEADOW CREST, ON L

SUBDIVISION: VILLAGE @ ISLE OF PINES SECTION: LOT # 24 LOT AREA: .689 ACRE DESIGN FLOW: 480 GPD L.T.A.R.: .25

Septic Tank 1000 (gal) STB 825 Date 8-10-14
Pump Tank (gal) PT Date
Pump Make Model Serial #
Nitrification Fields 1 # Lines 4 Linear Ft: 480'
Trench Width 36" Max. Trench Bottom Depth 24"-36" Gravel Depth N/A

☑ New System ☐ Repair ☐ Expansion System Type: I II III IV V VI
System Description: 25% REDUCTION - GRAVITY
Repair System Description: LPPPBPS
Maintenance Agreement Required: ☐ YES ☑ NO
☒ GRAVITY ☐ PRESSURE

☑ Residence ☐ Business ☐ Other ☒ Slab ☐ Basement w/plumbing
No. Bedrooms 4 No. Persons 8 No. Employees
☐ Crawl Space ☐ Basement w/o plumbing

Water Supply: ☐ Private ☐ Public ☒ Community

Comments / Conditions: TIGHT INSTALL TO MAINTAIN REPAIR AREA. CALL HEALTH DEPT. WITH ANY QUESTIONS.

INITIAL SITE SKETCH

SEE ATTACHED / APPROVED DESIGN BY MICHAEL ATHANAS & ASSOCIATES

DATED APPROVED MAR 12 2015

AS BUILT SKETCH

INSTALLED AS DRAWN

Permit can be suspended or revoked if any false information is supplied toward securing the permit / any unauthorized changes are made to the site / any unauthorized changes are made in the installation of the system. **CONTACT A LOCATOR SERVICE PRIOR TO ANY EXCAVATION**

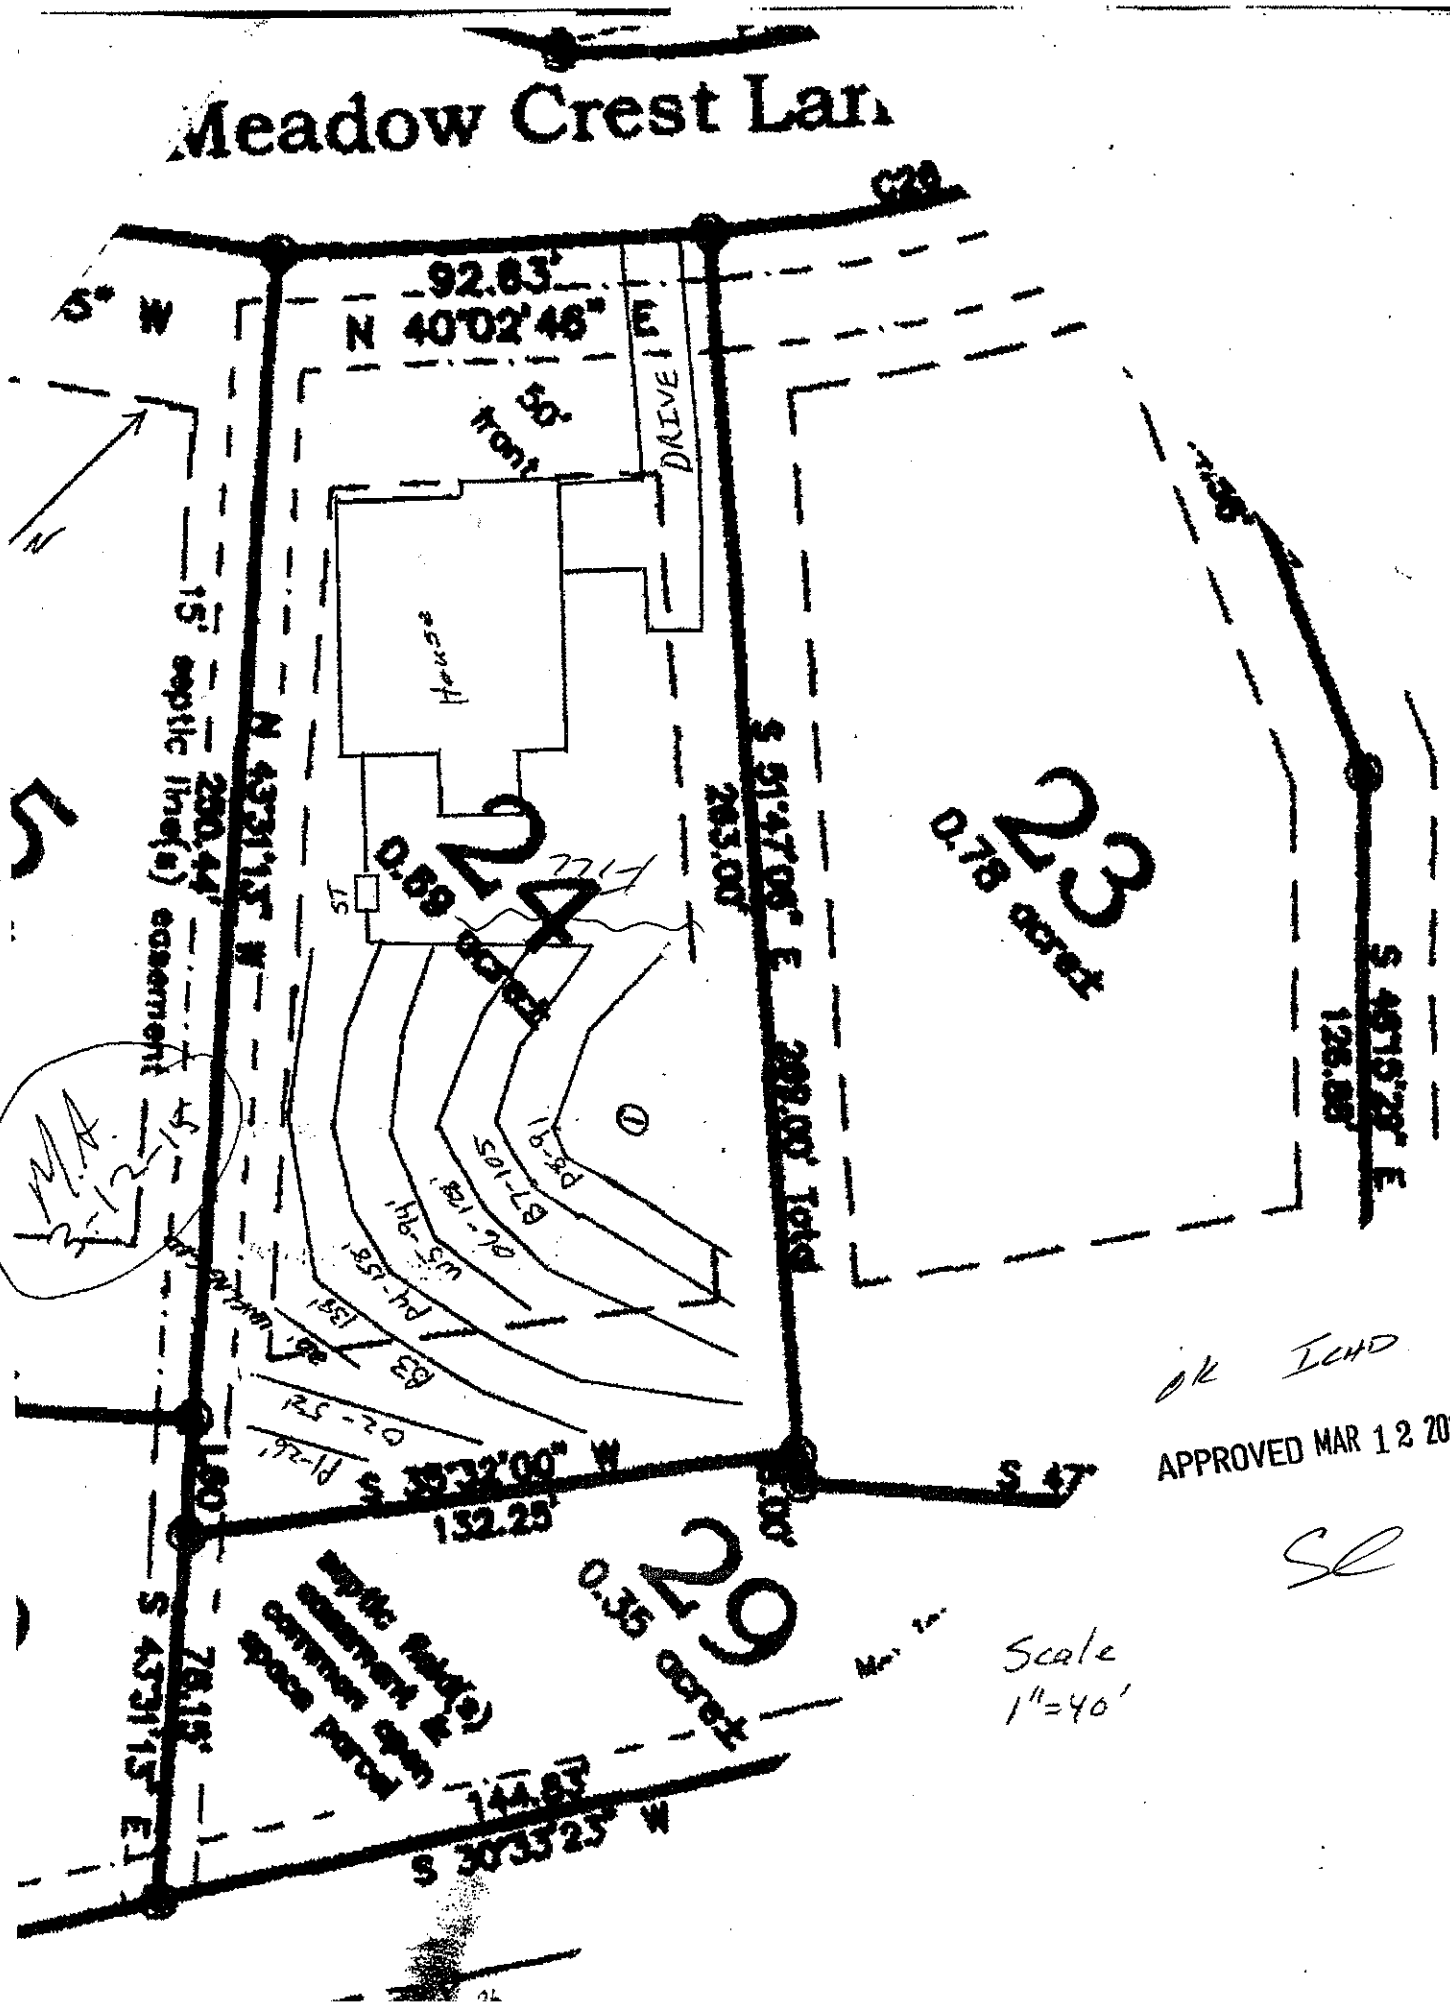
☐ **IMPROVEMENT PERMIT** *with plat valid without expiration.* ☒ **IMPROVEMENT PERMIT** *with site plan valid for 60 mos.* ☒ **AUTHORIZATION TO CONSTRUCT** *valid for period equal to IMPROVEMENT PERMIT--not to exceed 60 mo.*

Owner / Applicant Signature: KOWJSA Date: 3-12-15 Installed by: BONNELL SEPTIC

IMPROVEMENT PERMIT by: APPROVED MAR 12 2015 OPERATION PERMIT by: APPROVED APR 01 2015 Date:

AUTHORIZATION TO CONSTRUCT by: APPROVED MAR 12 2015 Existing System Inspected by: Date:

Health Dept. Copy - WHITE Applicant (Final Approval) - YELLOW Applicant (Conditional Approval) - PINK


Meadow Crest Lan
92.83'
N 40°02'46" E
DRIVE
House
septic line(s)
easement
15'
N 43°13'15" W
260.44'
S 51°47'08" E
265.00'
209.00' Total
0.69 acre
0.78 acre
S 45°13'52" E
128.88'
S 35°32'00" W
132.25'
S 43°13'15" E
78.15'
144.83'
S 30°33'25" W
0.35 acre
Scale
1"=40'
ok ICHD
APPROVED MAR 12 2015
SL