IREDELL COUNTY HEALTH DEPARTMENT

SVILLE 704-878-5305 MOORESVILLE 704-664-5281

IMPROVEMENT PERMIT / AUTHORIZATION TO CONSTRUCT / OPERATION PERMIT / EXISTING SYSTEM INSPECTION

PERMIT# 122282 PIN# 4636328692.037 Cell 4036323378 Cell DATE 7/6/06

OWNER OR CONTRACTOR Orleans Homebuilder/Glenn Loftiss PHONE: Business 201 916-0999 Home 361 0987 Rob

ADDRESS 1930-B Center Park Dr Charlotte NC 436 Hillcrest Pl #1 Palisades Park NJ 07650

LOCATION Brawley School Rd TL Isle of Pines TL Isle Run Dr TL Preserve Way TL Meadow Run Ln on left near end

SUBDIVISION Cove at Chesapeake BLOCK / SECTION ___ LOT 37 LOT AREA .694 acre SITE CLASS PS DESIGN FLOW 450 gpd L.T.A.R. .3

Septic Tank: 1500 Gallons; STB 338 Date 4-9-06 ☒ New System ☐ Repair System Type: I, II, III, IV, V, VI

Pump Tank: 1500 Gallons; PT 477 Date 4-12-06 System Description: Pump-Ul Panel/Blk

Pump Make: Myers Model ME 50 Serial No. ___ Repair System Description: Same

Nitrification Field: No Fields 1 Square Feet 672 Linear Feet 336 Maintenance Agreement Required: ☒ Yes ☐ No

No Lines 4 @ 84 Trench Width Minimum 24" Max Trench Bottom Depth 36" Gravel Depth N/A

☒ House/Mod. Home ☐ Mobile Home ☐ Business ☐ Other

No. Bedrooms 5 No. Bathrooms ___ No. Employees ___

☐ Slab ☒ Crawl Space ☐ Basement w/plumbing ☐ Basement wo/plumbing

Water Supply: ☐ Individual ☒ Public ☒ Community


Comments:/Conditions: ~~A~~ Use "in-line" Filter in Pump Tank

Filter installed 7/20/06

Comments:/Conditions: Note: Keep Future pool at least 15' from Septic System.

Checked tanks, lines & pressure 7/20/06

Scale 1:50 INITIAL SITE SKETCH

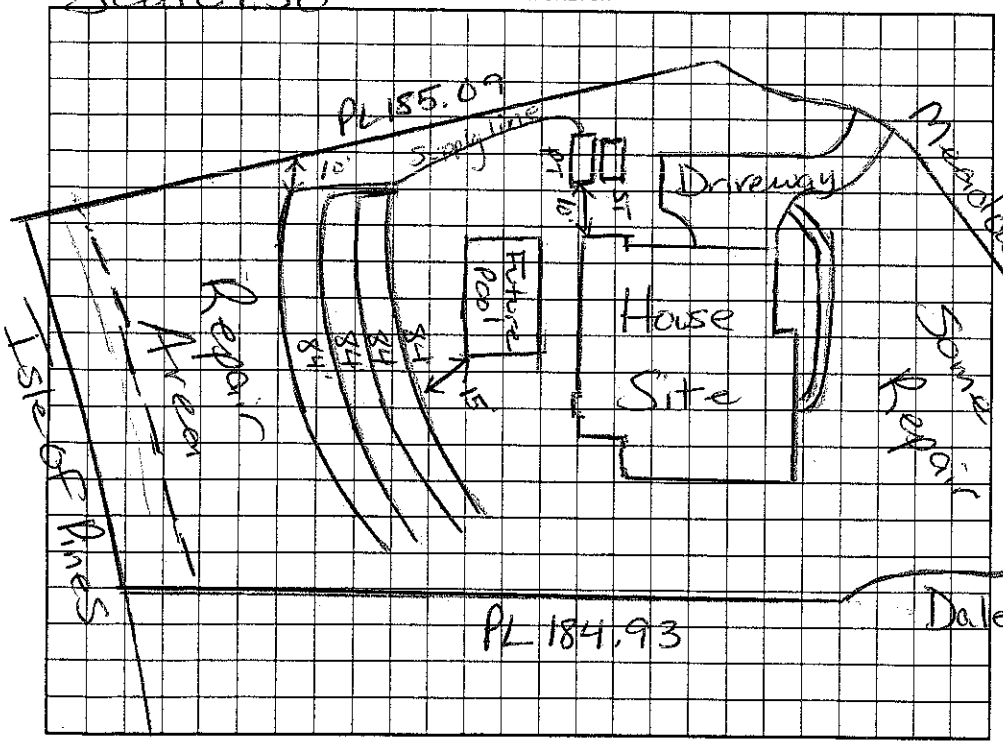

AS BUILT SKETCH

Permit can be suspended or revoked if any false information is supplied toward securing the permit/any unauthorized changes are made to the site/any unauthorized changes are made in the installation of the system. Improvement Permit with plat valid without expiration. Improvement Permit with site plan valid for sixty months. Authorization to Construct is valid for a period equal to that of Improvement Permit – not to exceed sixty months.

Signed: JB. Hamm IV

Improvement Permit by: Maria Hill Dotson RS date 7/6/06

Authorization to Construct by Maria Hill Dotson RS date 7/6/06

Installed by: Willie Christenbury

Operation Permit by: Maria Hill Dotson RS date 9/18/06

Existing System Inspection by: ___ date ___

HEALTH DEPT. COPY: WHITE OWNER COPY (FINAL): YELLOW OWNER COPY (INITIAL): PINK