IR[illegible]L COUNTY HEALTH DEPARTMENT

STATESVILLE 704-878-5305 MOORESVILLE 704-664-5281

IMP[illegible]EMENT PERMIT / AUTHORIZATION TO CONSTRUCT / OPERATION PERMIT / EXISTING SYSTEM INSPECTION

PERMIT# 122284 PIN# ~~4636-32-6692.000~~ 4636324173 DATE Oct 20, 04

OWNER OR CONTRACTOR Diesel Enterprises (Pine Isle LLC) / Rob Elvi PHONE: Business _____ Home _____

ADDRESS 125 Eastern Dr. Mooresville NC 28117

LOCATION Brawley School Rd TL Isle of Pines TL Isle of Pines Dr. TL Preserve Way TL Meadow Run TL Dale View Ct at end

SUBDIVISION The Great Outpeake Pt BLOCK / SECTION _____ LOT 39 LOT AREA .70 ac SITE CLASS. PS DESIGN FLOW 480 gpd L.T.A.R. .3

Septic Tank: 1000 Gallons; STB 194 Date 4-10-06
Pump Tank: 1000 Gallons; PT 283 Date 4-25-06
Pump Make: Myers Model ME50 Serial No. _____
Nitrification Field: No. Fields 1 Square Feet 540/810 Linear Feet 270
No Lines 3@90' Trench Width 24" min 36" max Max Trench Bottom Depth 36" Gravel Depth NA

☑ New System ☐ Repair System Type: I, II, III, IV, V, VI
System Description: LPPPBPS
Repair System Description: LPPPBPS
Maintenance Agreement Required: ☑ Yes ☐ No


☑ House/Mod. Home No. Bedrooms 4
☐ Mobile Home No. Bathrooms ____
☐ Business No. Employees ____
☐ Other _____
☐ Slab ☑ Crawl Space ☐ Basement w/plumbing ☐ Basement wo/plumbing

Water Supply: ☐ Individual ☑ Public ☑ Community

Comments:/Conditions:
"Shave off"/smooth the "old field edge". Very thick vegetation during I.O. Once lot is cleaned up, There may be other options available.
OR =36" max 9'oc

Comments:/Conditions: Checked tanks, lines & pressure 6/20/06

INITIAL SITE SKETCH 1"=50'

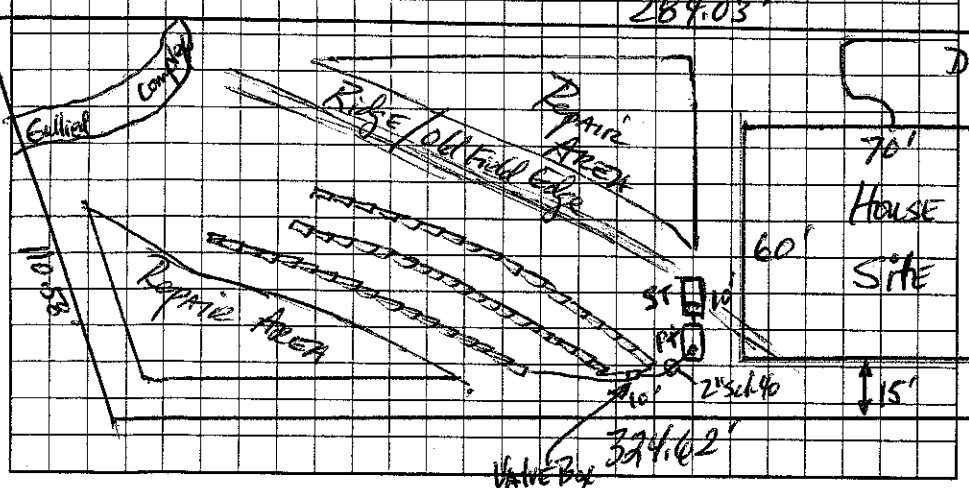

AS BUILT SKETCH

Installed essentially as Drawn

The proposed / existing ADDITION / SHED addition does not appear to impact the existing septic system.
**NOTE: _____ REHS
Date: 10-20-06
ICHD-Environmental Health Division

SEE ATTACHED SURVEY

Permit can be suspended or revoked if any false information is supplied toward securing the permit/any unauthorized changes are made to the site/any unauthorized changes are made in the installation of the system. Improvement Permit with plat valid without expiration. Improvement Permit with site plan valid for sixty months. Authorization to Construct is valid for a period equal to that of Improvement Permit – not to exceed sixty months.

Signed: _____ date 10-28-04 Installed by: Willie Christenbury

Improvement Permit by: _____ RS date 10-20-04 Operation Permit by: Judy Merrill date 7-27-06

Authorization to Construct by: _____ RS date 2/3/06 Existing System Inspection by: _____ date _____

HEALTH DEPT. COPY: WHITE OWNER COPY (FINAL): YELLOW OWNER COPY (INITIAL): PINK