IREDELL COUNTY HEALTH DEPARTMENT

STATESVILLE 704-878-5305 315.00 Paid MOORESVILLE 704-664-5281

IMPROVEMENT PERMIT / AUTHORIZATION TO CONSTRUCT / OPERATION PERMIT / EXISTING SYSTEM INSPECTION

PERMIT# 122279 PIN# ~~4636-32-8692.035~~ 4630324600 DATE Nov. 5, 04

OWNER OR CONTRACTOR Diewst Enterprises / Pine Isle LLC / Orleans Homes PHONE: Business Home

ADDRESS 125 Easton Dr. Mooresville N.C. 28117 – 2125 Sharon Lane - Charlotte 28211

LOCATION Brawley School Rd TL Isle of Pines TL Isle Row Dr. TL Preserve Way TL Meadow Run Ln. at End

SUBDIVISION The Cove at Chesapeake Pt. BLOCK / SECTION LOT 35 LOT AREA .83ac SITE CLASS. PS DESIGN FLOW 480gpd L.T.A.R. .3

Septic Tank: 1000 Gallons; STB 394 Date 5/16/06

Pump Tank: 1000 Gallons; PT 247 Date 5/8/06

Pump Make: Myers Model ME50 Serial No.

Nitrification Field: No Fields 1 Square Feet 540/810 Linear Feet 270

No Lines 3 Trench Width 24" min 8'oc Max Trench Bottom Depth 36" Gravel Depth NA

☑ New System ☐ Repair System Type: I, II, III, IV, V, VI

System Description: LPP/BPS

Repair System Description: LPP/BPS

Maintenance Agreement Required: ☑ Yes ☐ No

☑ House/Mod. Home No. Bedrooms 4

☐ Mobile Home No. Bathrooms

☐ Business No. Employees

☐ Other

☐ Slab ☑ Crawl Space ☐ Basement w/plumbing ☐ Basement wo/plumbing


Water Supply: ☐ Individual ☑ Public ☐ Community

Comments:/Conditions: OR 36" max 9'oc


Comments:/Conditions:

1"=50'

INITIAL SITE SKETCH

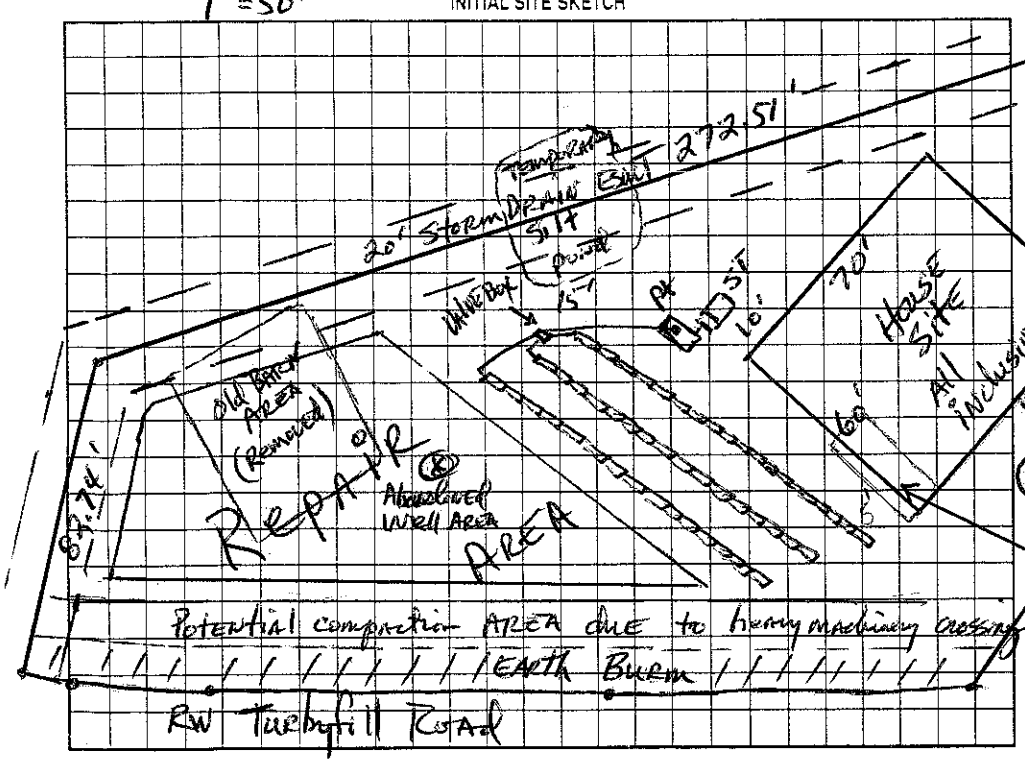

AS BUILT SKETCH

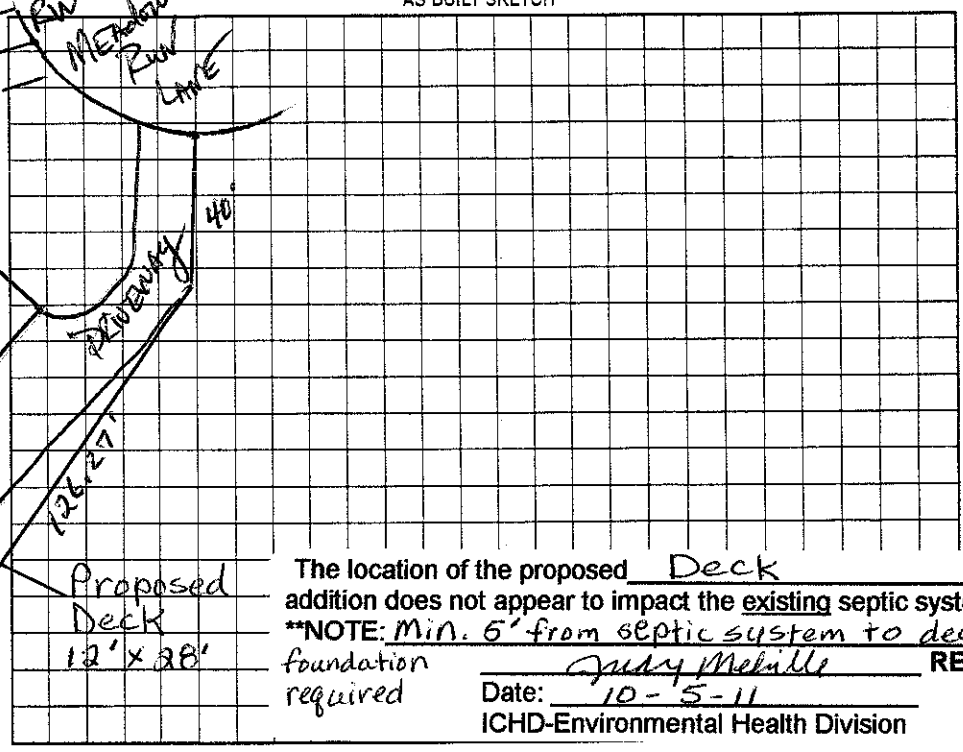

The location of the proposed Deck addition does not appear to impact the existing septic system.

**NOTE: Min. 6' from septic system to deck foundation required

Judy Melville REHS

Date: 10-5-11

ICHD-Environmental Health Division

Permit can be suspended or revoked if any false information is supplied toward securing the permit/any unauthorized changes are made to the site/any unauthorized changes are made in the installation of the system. Improvement Permit with plat valid without expiration. Improvement Permit with site plan valid for sixty months. Authorization to Construct is valid for a period equal to that of Improvement Permit – not to exceed sixty months.

Signed: Vonnylee date 1-13-05

Improvement Permit by: date 11-5-04

Authorization to Construct by: date 2/14/06

Installed by: Christian Watson

Operation Permit by: date 7/11/06

Existing System Inspection by: date

HEALTH DEPT. COPY: WHITE OWNER COPY (FINAL): YELLOW OWNER COPY (INITIAL): PINK