IREDELL COUNTY HEALTH DEPARTMENT

STATESVILLE 704-878-5305 MOORESVILLE 704-664-5281

3:30

IMPROVEMENT PERMIT / AUTHORIZATION TO CONSTRUCT / OPERATION PERMIT / EXISTING SYSTEM INSPECTION

PERMIT# 122275 PIN# ~~4636-32-8692.054~~ 4636325614 DATE Oct 20, 04

OWNER OR CONTRACTOR Dienst Enterprises (Five Isle LLC) Orle PHONE: Business _____ Home _____

ADDRESS 125 Easton Dr, Mooresville, NC 28117

LOCATION Brawley School Rd TL Isle of Pines TL Isle Run Dr. TL Preserve Way TL Meadow Run Lane, attend on Right

SUBDIVISION The Cove at Chesapeake Pt BLOCK / SECTION _____ LOT 34 LOT AREA .69ac SITE CLASS PS DESIGN FLOW 440gpd L.T.A.R. .25

Septic Tank: 1000 Gallons; STB 283 Date 3-25-07
Pump Tank: 1000 Gallons; P.T 794 Date 3-7-07
Pump Make: Myers Model ME50511 Serial No. _____
Nitrification Field: No Fields 1 Square Feet 640/960 Linear Feet 320
No Lines 3 Trench Width 24" min 36" Max Trench Bottom Depth 36" Gravel Depth NA

☑ New System ☐ Repair System Type: I, II, III, IV, V, VI
System Description: LPPPBPS
Repair System Description: LPPPBPS
Maintenance Agreement Required: ☑ Yes ☐ No

☑ House/Mod. Home No. Bedrooms 4
☐ Mobile Home No. Bathrooms ___
☐ Business No. Employees ___
☐ Other _____
☐ Slab ☑ Crawl Space ☐ Basement w/plumbing ☐ Basement wo/plumbing


Water Supply: ☐ Individual ☑ Public ☑ Community

Comments/Conditions: OR = 36" min 96c
"Shave off" old berm
Anti-Syphon hole Required.

Comments/Conditions: 25 panels for patch
3/16" hole drilled
5/3/07 Checked tanks & lines
5/3/07 Pressure test

INITIAL SITE SKETCH

1"=50'

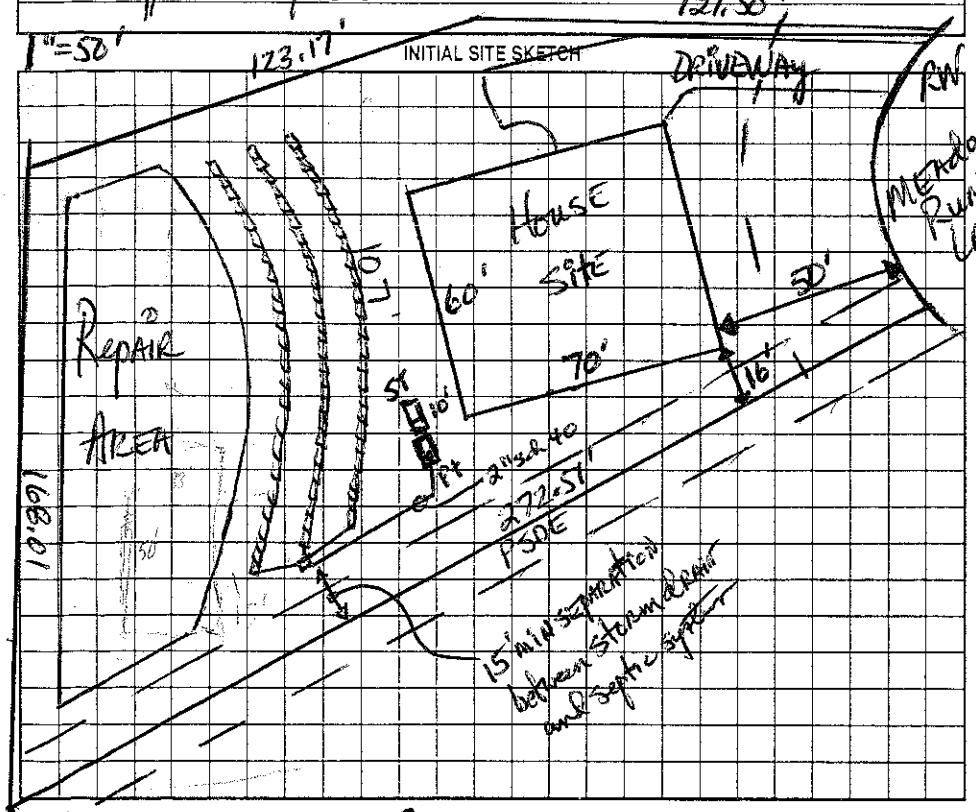

AS BUILT SKETCH

Repair Area changed
see Existing System
(Danielle Grancagnolo
1/23/08

Permit can be suspended or revoked if any false information is supplied toward securing the permit/any unauthorized changes are made to the site/any unauthorized changes are made in the installation of the system. Improvement Permit with plat valid without expiration; Improvement Permit with site plan valid for sixty months. Authorization to Construct is valid for a period equal to that of Improvement Permit – not to exceed sixty months.

Signed: _____ date 10.28.04 Installed by: Willie Christenbury

Improvement Permit by: D.R. Hamer RS date 10-20-04 Operation Permit by: Wesley Sparks RS. date 6/14/07

Authorization to Construct by: Wesley Sparks RS. date 12/20/06 Existing System Inspection by: _____ date _____

HEALTH DEPT. COPY: WHITE OWNER COPY (FINAL): YELLOW OWNER COPY (INITIAL): PINK