IREDELL COUNTY HEALTH DEPARTMENT

STATESVILLE 704-878-5305 MOORESVILLE 704-664-5281

IMPROVEMENT PERMIT / AUTHORIZATION TO CONSTRUCT / OPERATION PERMIT / EXISTING SYSTEM INSPECTION

PERMIT# 122272 PIN# ~~4636-32-8692.032~~ 4636326485 DATE Oct. 19, 04

OWNER OR CONTRACTOR Diesel Enterprises (Pine Isle LLC)/Robert E PHONE: Business _____ Home _____

ADDRESS 125 Dorsey Dr. Mooresville, NC 28117

LOCATION Brawley School Rd. TL Isle of Pines TL Isle Run Dr. TL Preserve Way TL Meadow Run Ln. on Right

SUBDIVISION The Cove at Chesapeake Pt. BLOCK / SECTION _____ LOT 32 LOT AREA 1.69 Ac SITE CLASS PS DESIGN FLOW 480gpd L.T.A.R. .25

Septic Tank: 1000 Gallons; STB 794 Date 4-24-06
Pump Tank: 1000 Gallons; PT 283 Date 4-21-06
Pump Make: Myers Model ME 50 Serial No. _____
Nitrification Field: No. Fields 1 Square Feet 640/960 Linear Feet 320
No Lines 45 Trench Width 24" MIN @ 6'OC Max Trench Bottom Depth 36" Gravel Depth N/A

☒ New System ☐ Repair System Type: I, II, III, ⓘ V, VI
System Description: LPPPBPS
Repair System Description: LPPPBPS
Maintenance Agreement Required: ☑ Yes ☐ No


☐ House/Mod. Home No. Bedrooms 4
☐ Mobile Home No. Bathrooms ____
☐ Business No. Employees ____
☐ Other _____
☐ Slab ☑ Crawl Space ☐ Basement w/plumbing ☐ Basement wo/plumbing

Water Supply: ☐ Individual ☒ Public ☒ Community

Comments/Conditions: @ 36" max 9'OC 5064
"Shave off" old berm
Anti syphon hole required.

Comments/Conditions: Drilled 3/16" hole
Filter installed in PT
Pressure, tanks & Field checked 6/7/06

INITIAL SITE SKETCH

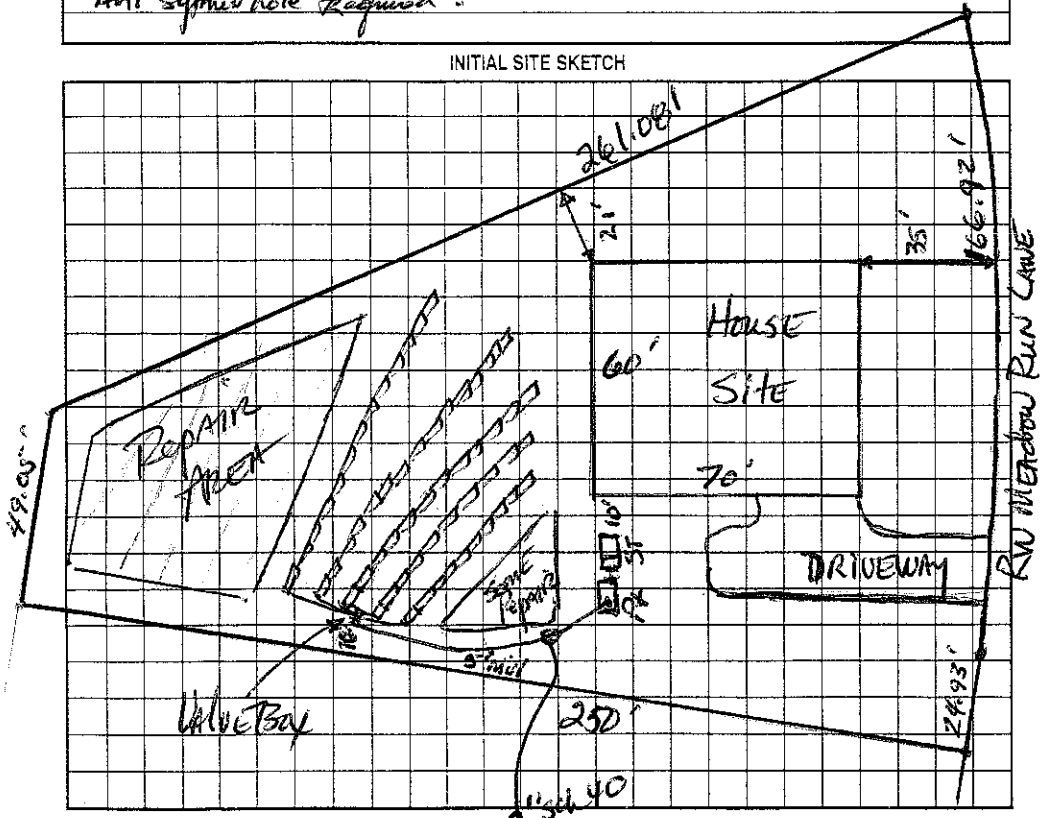

AS BUILT SKETCH

Installed 5 lines @ 64 ft ea.

Permit can be suspended or revoked if any false information is supplied toward securing the permit/any unauthorized changes are made to the site/any unauthorized changes are made in the installation of the system. Improvement Permit with plat valid without expiration. Improvement Permit with site plan valid for sixty months. Authorization to Construct is valid for a period equal to that of Improvement Permit – not to exceed sixty months.

Signed: _____ date 10.25.04 Installed by: Willie Christenbury

Improvement Permit by: _____ RS date 10-19-04 Operation Permit by: _____ RS date 6/25/06

Authorization to Construct by: _____ RS date 12/28/05 Existing System Inspection by: _____ date _____

HEALTH DEPT. COPY: WHITE OWNER COPY (FINAL): YELLOW OWNER COPY (INITIAL): PINK