REDE[illegible]LL COUNTY HEALTH DEPARTMENT

STATESVILLE 704-878-5305 MOORESVILLE 704-664-5281

IMPROVEMENT PERMIT / AUTHORIZATION TO CONSTRUCT / OPERATION PERMIT / EXISTING SYSTEM INSPECTION

PERMIT# 12273 PIN# 4636328692,033 4636326527 DATE 7-6-06

OWNER OR CONTRACTOR Orleans Home Builders, Vannoy PHONE: Business 658-1171 Cell Home 361-0982

ADDRESS 1930-B Center Park Dr. Charlotte NC 28217

LOCATION Brawley School Rd TL Isle of Pines S TL Isle Run Dr TL Preserve Way TL Meadow Run Ln

SUBDIVISION Cove on Chesapeake PH BLOCK / SECTION ____ LOT 33 LOT AREA .69 Acre SITE CLASS. PS DESIGN FLOW 480gpd L.T.A.R. .25 to .3

Septic Tank: 1000 Gallons; STB 794 Date 3-19-06

Pump Tank: 1000 Gallons; PT B&C 169 Date 8-14-06

Pump Make: ____ Model ____ Serial No. ____

Nitrification Field: No Fields 1 Square Feet 800' Linear Feet 400'

No Lines 4@100' Trench Width 24" Max Trench Bottom Depth 36" Gravel Depth N/A

☒ New System ☐ Repair System Type: I, II, III, IV, V, VI

System Description: Pump-LP-Panel Block

Repair System Description: Same

Maintenance Agreement Required: ☒ Yes ☐ No

☒ House/Mod. Home ☐ Mobile Home ☐ Business ☐ Other

No. Bedrooms 4 No. Bathrooms ____ No. Employees ____


☐ Slab ☐ Crawl Space ☐ Basement w/plumbing ☐ Basement wo/plumbing

Water Supply: ☐ Individual ☒ Public ☒ Community

Comments:/Conditions: Note: Okay to Center feed lines
*Use In line filter in PT
Scale 1:50

Comments:/Conditions: Keep any future swimming pool at least 15ft from Septic System. Checked tanks 7/21/06 Checked lines & pres. 7/[illegible] 3/16" hole drilled

INITIAL SITE SKETCH

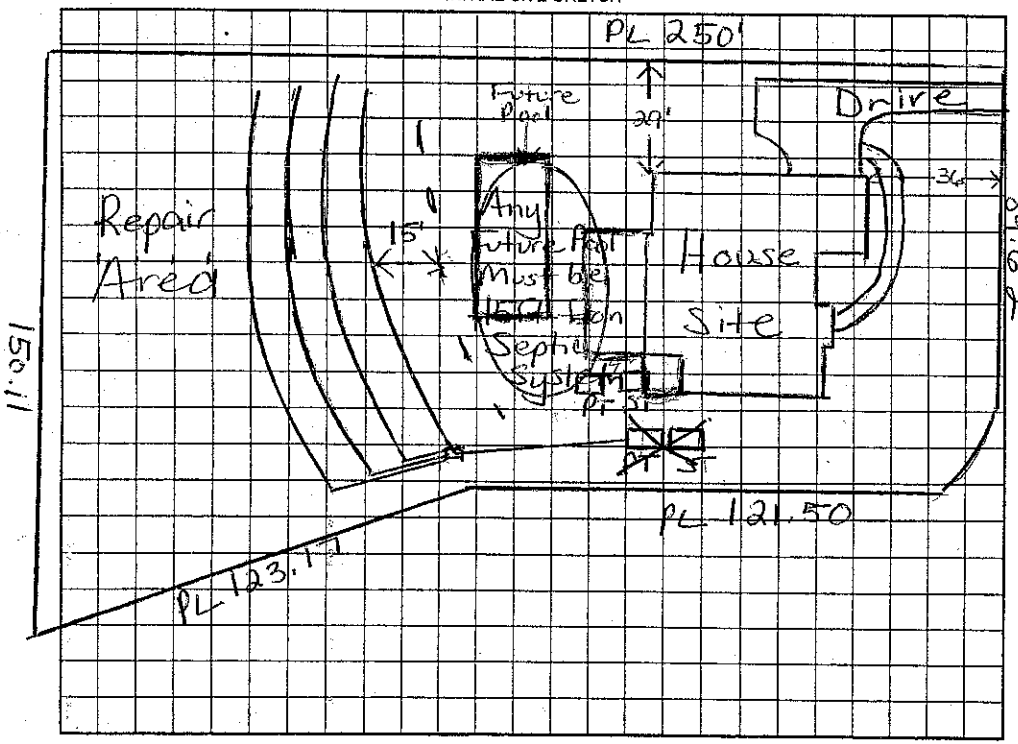

AS BUILT SKETCH

The proposed / existing Inground Swimming pool addition does not appear to impact the existing septic system

**NOTE: Must keep Pool Cut at least 15ft from Septic Maria Dotson REHS

Date: 7/10/2011

ICHD-Environmental Health Division

Permit can be suspended or revoked if any false information is supplied toward securing the permit/any unauthorized changes are made to the site/any unauthorized changes are made in the installation of the system. Improvement Permit with plat valid without expiration. Improvement Permit with site plan valid for sixty months. Authorization to Construct is valid for a period equal to that of Improvement Permit – not to exceed sixty months.

Signed: [signature] date 2-10-06

Improvement Permit by: Maria H. Dotson RS date 7/6/06

Authorization to Construct by: Maria H. Dotson RS date 7/6/06

Installed by: Willie Christenbury

Operation Permit by: Maria H. Dotson RS date 9/15/06

Existing System Inspection by: ____ date ____

HEALTH DEPT. COPY: WHITE OWNER COPY (FINAL): YELLOW OWNER COPY (INITIAL): PINK