IREDELL COUNTY HEALTH DEPARTMENT

STATESVILLE 704-878-5305 MOORESVILLE 704-664-5281

IMPROVEMENT PERMIT / AUTHORIZATION TO CONSTRUCT / OPERATION PERMIT / EXISTING SYSTEM INSPECTION

PERMIT# 12273 PIN# 4636328692.033 4636326527 Cell DATE 7-6-06

OWNER OR CONTRACTOR Orleans Home Builders PHONE: Business 658-1171 Home 361-0982

ADDRESS 1930-B Center Park Dr Charlotte NC 28217

LOCATION Brawley School Rd TL Isle of Pines TL Isle Run Dr TL Preserve Way TL Meadow Run Ln on right

SUBDIVISION Cove @ Chesapeake I BLOCK / SECTION LOT 33 LOT AREA .69 Acre SITE CLASS. PS DESIGN FLOW 480gpd L.T.A.R. .25 to .3

Septic Tank: 1000 Gallons; STB 794 Date 3-19-06
Pump Tank: 1000 Gallons; PT B&C 169 Date 5-14-04
Pump Make: Model Serial No.
Nitrification Field: No Fields 1 Square Feet 800' Linear Feet 400'
No Lines 4@100' Trench Width 24" Max Trench Bottom Depth 36" Gravel Depth N/A

☒ New System ☐ Repair System Type: I, II, III, (IV), V, VI
System Description: Pump-LP-Panel Block
Repair System Description: Same
Maintenance Agreement Required: ☒ Yes ☐ No


☒ House/Mod. Home No. Bedrooms 4
☐ Mobile Home No. Bathrooms
☐ Business No. Employees
☐ Other
☐ Slab ☐ Crawl Space ☐ Basement w/plumbing ☐ Basement wo/plumbing

Water Supply: ☐ Individual ☒ Public ☒ Community

Comments:/Conditions: Note: Okay to Center feed lines
* Use In line filter in PT
Scale 1:50

Comments:/Conditions: Keep any future swimming pool at least 15Ft from Septic System.
Checked tanks 7/21/06 Checked lines & pres. 7/25/06
3/16 hole drilled

INITIAL SITE SKETCH

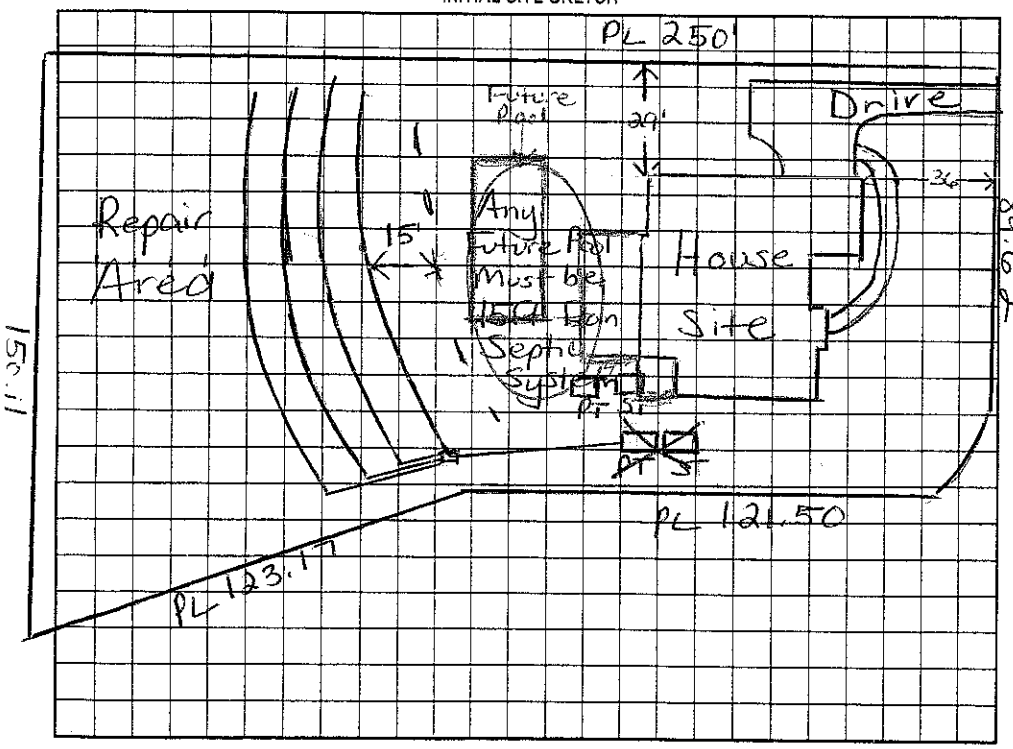

AS BUILT SKETCH

Permit can be suspended or revoked if any false information is supplied toward securing the permit/any unauthorized changes are made to the site/any unauthorized changes are made in the installation of the system. Improvement Permit with plat valid without expiration. Improvement Permit with site plan valid for sixty months. Authorization to Construct is valid for a period equal to that of Improvement Permit – not to exceed sixty months.

Signed: JB Ann DA date 7-10-06
Improvement Permit by: Maria HH Dotson RS date 7/6/06
Authorization to Construct by: Maria HH Dotson RS date 7/6/06

Installed by: Willie Christenbury
Operation Permit by: Maria HH Dotson RS date 9/15/06
Existing System Inspection by: date

HEALTH DEPT. COPY: WHITE OWNER COPY (FINAL): YELLOW OWNER COPY (INITIAL): PINK