IREDELL COUNTY HEALTH DEPARTMENT

Application For Improvement Permit and/or Authorization To Construct, Existing System Inspection

(THE ABOVE PERMIT DOCUMENTS WILL BECOME INVALID IF INFORMATION PROVIDED ON THIS APPLICATION IS FALSIFIED OR CHANGED, OR IF THE SITE IS ALTERED. THE IMPROVEMENT PERMIT IS VALID FOR EITHER 60 MONTHS OR WITHOUT EXPIRATION DEPENDING UPON DOCUMENTATION SUBMITTED - APPLICATION WITH SITE PLAN 60 MONTHS, APPLICATION WITH COMPLETE, SCALED PLAT WITHOUT EXPIRATION. SEE 15A NCAC 18A .1937(f) FOR DETAILS)

1. APPLICATION FOR: ___ Improvement Permit ___Authorization To Construct X BOTH ___Existing System Inspection

2. Page 2: *Site Plan Worksheet* Form MUST Accompany This Application RE DRAW
The following optional attachments may also be submitted:
Place check ( ) beside whichever is submitted if applicable
___ Survey Plat, Scaled no more than 1 Inch = 60 Feet
___ Custom Site Plan, Scaled no more than 1 Inch = 60 Feet

3. **Applicant Information:**

~~Owners~~ Rob Earn		704-361-0987	704-658-1171
Applicant Name	Mailing Address	Cell ~~Home~~ Phone	Work Phone
Orleans Homebuilders	1930-B Camden Park Dr Charlotte NC 28217		704-357-6632
Owner Name	Mailing Address	Home Phone	Work Phone

4. **Property Information:**

126 Meadow Run Lane	Ice Cove	33
Street Address	Subdivision Name	Section/Phase and Lot Number

Driving Directions: _____

****

5. **RESIDENTIAL Site Development Information:** *(Check or Complete ALL that apply)*

(X) New, Single Family Residence
( ) New, Multi-Family Residence
( ) Expansion of Existing Septic System
( ) Repair To Failing Septic System

Maximum Number of Bedrooms 4
Maximum Number of Occupants ___
If Expansion, Current Number of Bedrooms ___

(X) Crawl Space Foundation?
( ) Concrete Slab Foundation?
( ) Basement w/Plumbing?
( ) Basement w/out Plumbing?

IF Non-Residential Site Development: Type of Business _____
Square Footage of Building _____
Maximum Number of Employees _____
Maximum Number of Seats _____

****

6. **Proposed Water Supply:**

( ) New Well ( ) Existing Well (X) Community Well ( ) City Water ( ) Other Public Water

****

7. **Desired Septic System Type:** *(You may rank in order of preference, if any)*

( ) Alternative ( ) Conventional (X) Innovative T&J Panels ( ) Modified Conventional ( ) Other_____ ( ) No Preference

****

8. **Please Answer The Following To The Best of Your Ability:**

( ) Yes (X) No Does the site contain any jurisdictional wetlands?
( ) Yes (X) No Is any non-domestic sewage (i.e. industry) to be generated?
( ) Yes (X) No Is the site subject to approval by any other public agency?

****

I have read this application and certify that the information provided herein is true, complete, and correct. Authorized county and state officials are granted right of entry to conduct necessary inspections to determine compliance with applicable laws and rules. I understand that I am solely responsible for the proper identification and labeling of all property lines and corners and making the site accessible so that a complete site evaluation can be performed.

9. Signature: _____
Property owner or owner's legal representative signature (SIGNATURE REQUIRED)

6/23/06
DATE

IREDELL COUNTY HEATLH DEPARTMENT

PAGE 2: *SITE PLAN WORKSHEET*

SEE THE SAMPLE SITE PLAN BELOW. INCOMPLETE SITE PLANS WILL BE RETURNED TO YOU FOR COMPLETION AND MAY RESULT IN A DELAY IN THE ISSUANCE OF YOUR SEPTIC SYSTEM PERMIT!!!

Place an (X) beside each item as you complete the site plan:

_____ **Property Line measurements are clearly identified…**
_____ **All proposed structures are indicated…**
SHOW: proposed house or business footprint, wells, water lines, patios, pools and decks, and any other item that will occupy space on the site
_____ **Front and side setbacks from property line…**
_____ **Preferred driveway location and configuration, preferred well location…**
_____ **Area you prefer your septic system to be placed…**
_____ **North arrow, or other sufficient indicator of direction…**


Circle N/A on the following if appropriate:


_____ **Location of septic systems and wells within 100' of your property… N/A**
_____ **Location of easements and rights of ways on your property… N/A**
_____ **Location of any designated wetlands on the property… N/A**

Signature: _____
Property owner or owner's legal representative signature (SIGNATURE REQUIRED)


6/29/06
DATE


USE THIS SPACE TO DRAW YOUR SITE PLAN

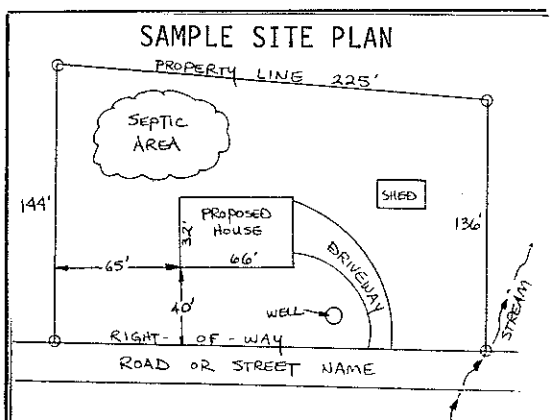

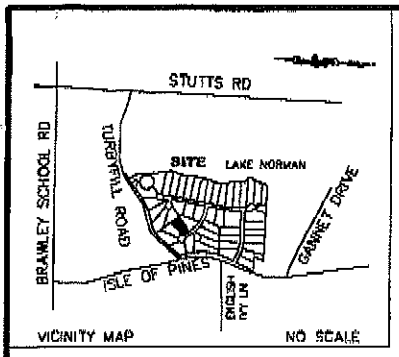

CURVE TABLE				
CURVE	RADIUS	LENGTH	CHORD BEARING	CHORD
C1	25.00	22.12	S21°32'56"E	21.41
C2	50.00	3.09	N02°01'48"E	3.09

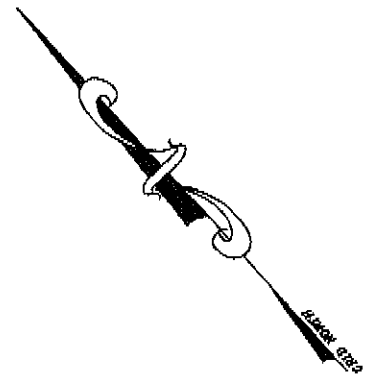

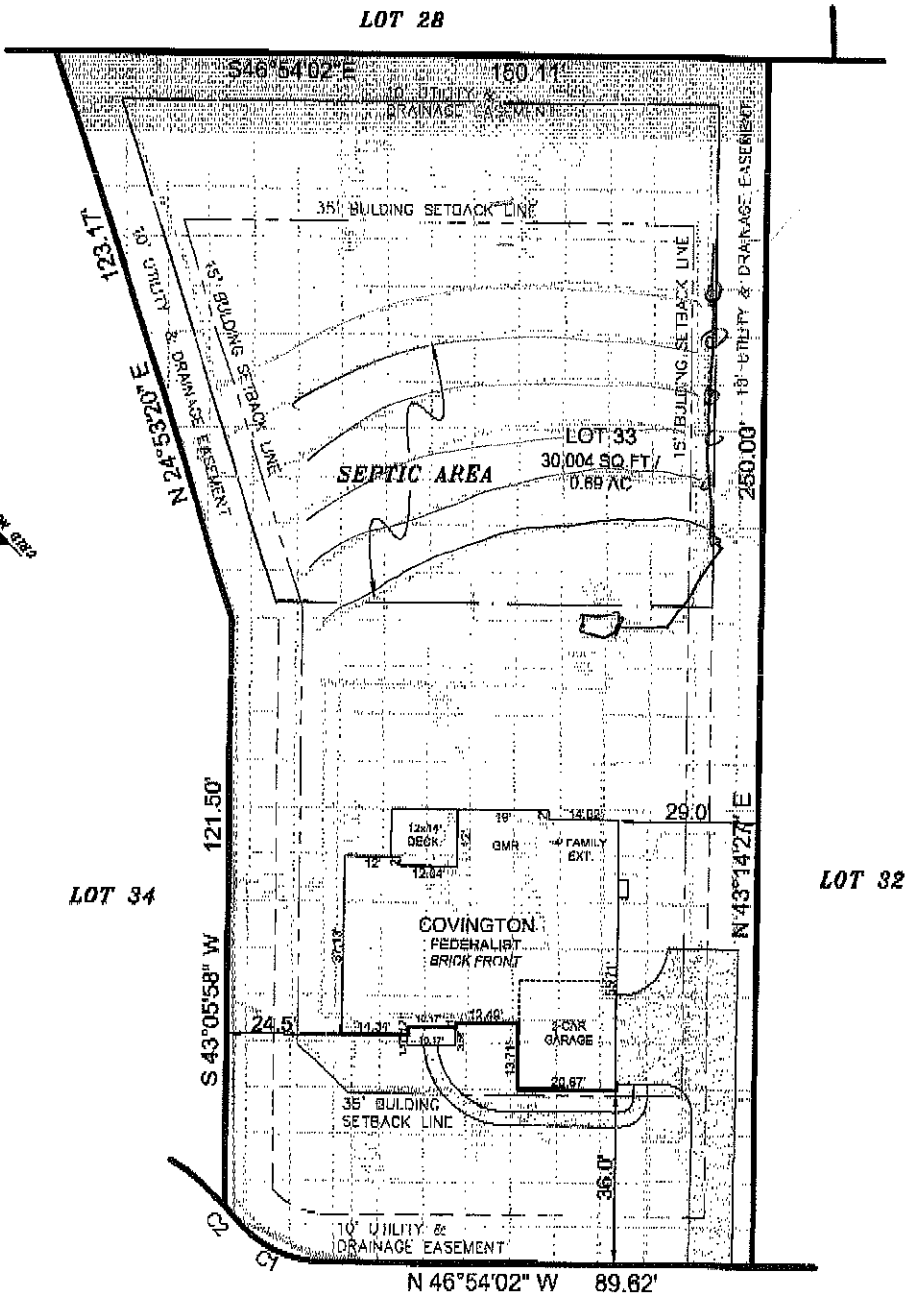


MEADOW RUN LANE
45' PUBLIC R/W

Minimum Building SetbackS:
35' Front, 35' Rear
25' Corner, 15' Side

All lots are subject to a 10' Utility and Drainage Easement. 10 feet on each side of the property line.

R/W = RIGHT-OF-WAY

REF.: PLAT BOOK 46 PAGE 77

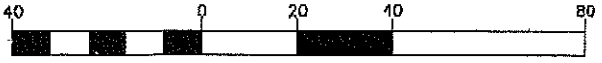

GRAPHIC SCALE
1 INCH = 40 FT

PLOT PLAN

THE COVE at CHESAPEAKE POINT
DAVIDSON TOWNSHIP, IREDELL COUNTY, NC

LOT 33
MEADOW RUN LANE

TAYLOR WISEMAN & TAYLOR
ENGINEERS | SURVEYORS | SCIENTISTS
SUBSURFACE UTILITY ENGINEERS
4101-F STUART ANDREW BLVD., CHARLOTTE, NC 28217
PHONE (704) 527-2636 FAX (704) 527-2637

SCALE: 1" = 40'	DATE: JANUARY 13, 2006	FILE: 70425.0005.00
DRAWN BY: JES	CHECKED BY: JES	SHEET: 1\1