IREDELL COUNTY HEALTH DEPARTMENT

STATESVILLE 704-878-5305 COPY MOORESVILLE 704-664-5281

IMPROVEMENT PERMIT / AUTHORIZATION TO CONSTRUCT / OPERATION PERMIT / EXISTING SYSTEM INSPECTION

PERMIT# 122-255 PIN# ~~4636-32-8072.000~~ 4636327724

OWNER OR CONTRACTOR Diewst Enterprises (Pine Isle LLC) / R [redacted] DATE Oct. 12, 04

ADDRESS 125 Easton Dr. Mooresville, NC 28117

LOCATION Berkley Sch Rd. TL Isle of Pines TL Isle Run Dr. TL Preserve Way TL Estate View Ct. Home 105 Estate View Ct. Head on left

SUBDIVISION The Cove at Chesapeake Pt BLOCK / SECTION LOT 28 LOT AREA .69ac SITE CLASS. BS DESIGN FLOW 420gpd L.T.A.R. .25 initial / .3 Repair

Septic Tank: 1000 Gallons; STB 312 Date 5-20-06

Pump Tank: 1000 Gallons; PT 283 Date 5-15-06

Pump Make: Myers Model ME 50 Serial No.

Nitrification Field: No. Fields 1 Square Feet 640/960 Linear Feet 320

No. Lines (4-5) Trench Width 24" min 18" Max Trench Bottom Depth 36"

☑ New System ☐ Repair System Type: I, II, III, (IV), V, VI

System Description: LPPPBPS

Repair System Description: LPPPBPS

Maintenance Agreement Required: ☑ Yes ☐ No

Gravel Depth N/A

~~☐ House/Mod.~~ ☐ Mobile Home ☐ Business ☐ Other

No. Bedrooms 4 No. Bathrooms ___ No. Employees ___


☐ Slab ☑ Crawl Space ☐ Basement w/plumbing ☐ Basement wo/plumbing

Water Supply: ☐ Individual ☑ Public ☐ Community

Comments/Conditions: OR = 36" MAX 9' OC

Comments/Conditions: 3/16" hole
Checked tanks & lines 6/22/06

INITIAL SITE SKETCH 1"=50'

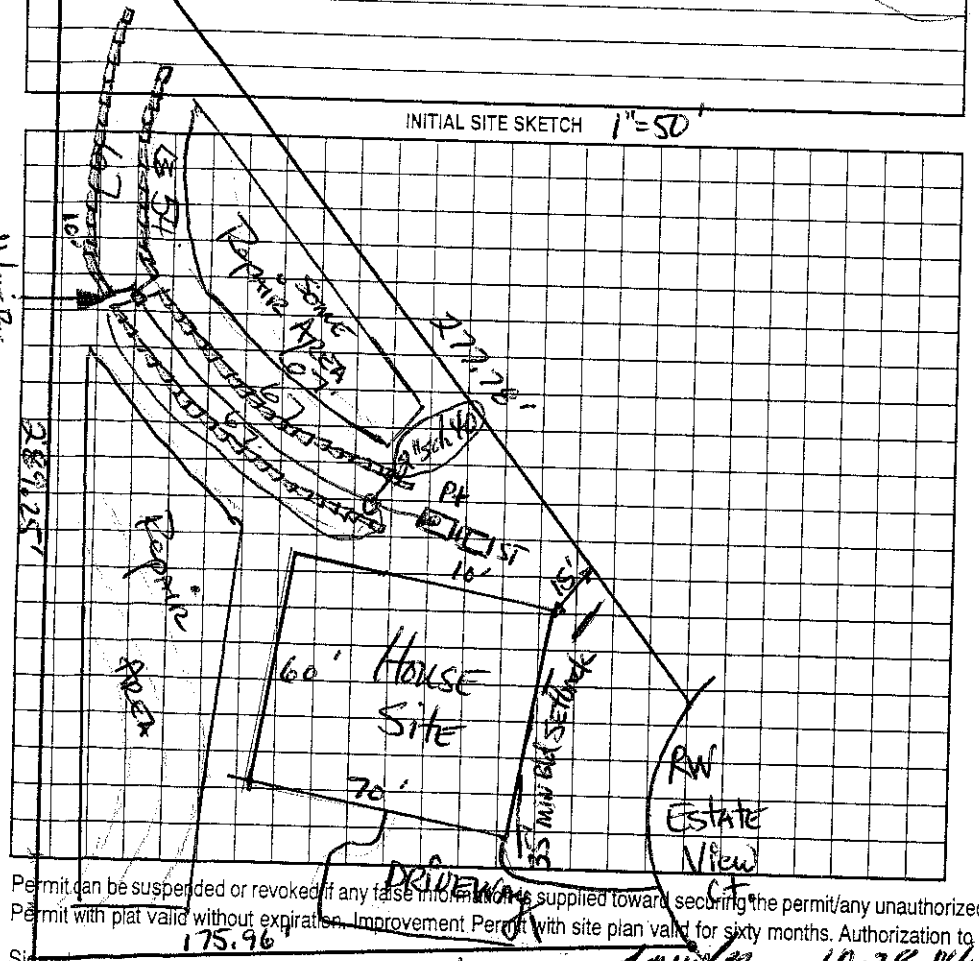

AS BUILT SKETCH

House is only ≈50' deep leaving room for deck

The location of the proposed Deck addition does not appear to impact the existing septic system.

**NOTE:

5-A-08

Date: 3-9-11 REHS

ICHD-Environmental Health Division

Permit can be suspended or revoked if any false information is supplied toward securing the permit/any unauthorized changes are made to the site/any unauthorized changes are made in the installation of the system. Improvement Permit with plat valid without expiration. Improvement Permit with site plan valid for sixty months. Authorization to Construct is valid for a period equal to that of Improvement Permit – not to exceed sixty months.

Signed: Tony Ke date 10.28.04 Installed by: Willie Christenbury

Improvement Permit by: [signature] RS date 10-12-04 Operation Permit by: Jerry McNeill date 7-26-06

Authorization to Construct by: [signature] RS date 2/7/06 Existing System Inspection by: ___ date ___

HEALTH DEPT. COPY: WHITE OWNER COPY (FINAL): YELLOW OWNER COPY (INITIAL): PINK