IREDELL COUNTY HEALTH DEPARTMENT

STATESVILLE 704-878-5305 MOORESVILLE 704-664-5281

IMPROVEMENT PERMIT / AUTHORIZATION TO CONSTRUCT / OPERATION PERMIT / EXISTING SYSTEM INSPECTION

PERMIT# 122253 PIN# ~~4636-32-8692.026~~ 4636327924 Rob 361-0987 DATE Oct. 8, 04

OWNER OR CONTRACTOR Dienst Enterprises (PINE ISLE LLC)/Orleans Homes PHONE: Business _____ Home _____

ADDRESS 125 Easton Dr, Mooresville NC 28117

LOCATION Brawley Sch Rd TL Isle of Pines TL Isle Run Dr. TL Preserve Way TL Estate View Ct. on Right

SUBDIVISION The Cove at Chesapeake Pt. BLOCK / SECTION _____ LOT 26 LOT AREA .81ac SITE CLASS. PS DESIGN FLOW 480gpd L.T.A.R. .3

Septic Tank: 1000 Gallons: STB 312 Date 9/24/05
Pump Tank: 1000 Gallons: PT 283 Date 6/20/06
Pump Make: Myers Model ME50-511 Serial No. _____
Nitrification Field: No Fields 1 Square Feet 540/810 Linear Feet 270
No Lines 3 Trench Width 24" min Bloc Max Trench Bottom Depth 36" Gravel Depth N/A

☑ New System ☐ Repair System Type: I, II, III, IV, V, VI
System Description: LPPPBPS
Repair System Description: LPPPBPS
Maintenance Agreement Required: ☑ Yes ☐ No

☑ House/Mod. Home No. Bedrooms 4
☐ Mobile Home No. Bathrooms ____
☐ Business No. Employees ____
☐ Other _____

☐ Slab ☑ Crawl Space ☐ Basement w/plumbing ☐ Basement wo/plumbing

Water Supply: ☐ Individual ~~☐ Public~~ ~~☑ Community~~


Comments:/Conditions: OR 36" max 9'oc

"Shave off" old burms in septic system area 8/3/06


Comments:/Conditions:

60 Pavers
3/16" holes
Tanks, lines & pressure checked by GM

INITIAL SITE SKETCH

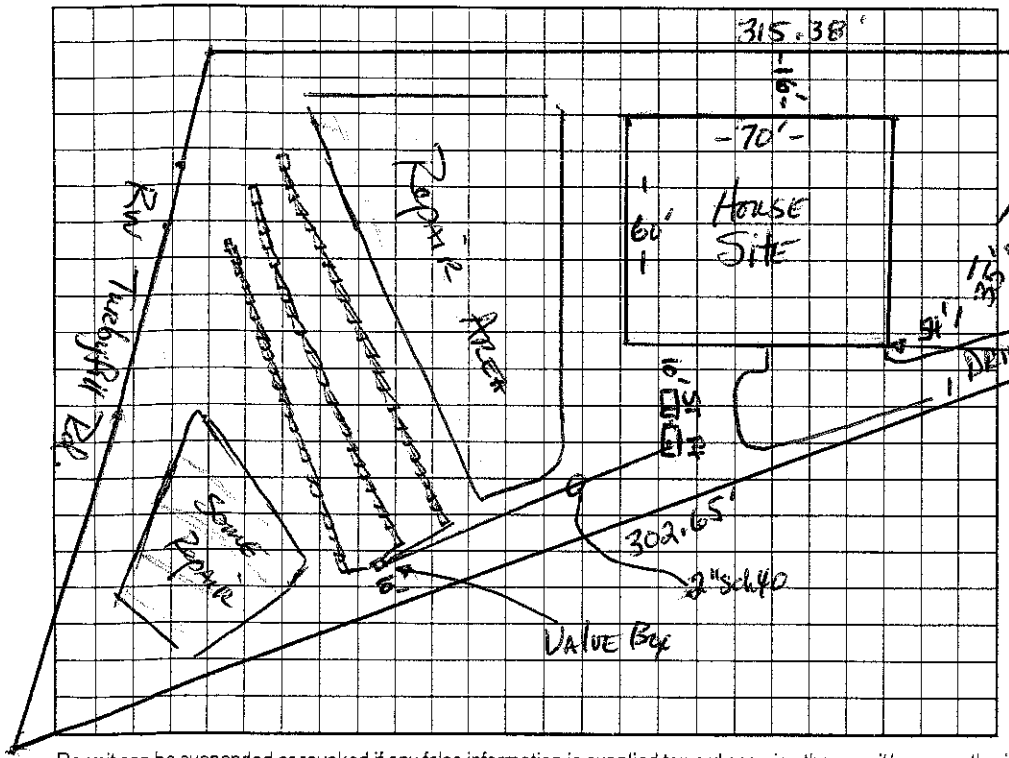

AS BUILT SKETCH

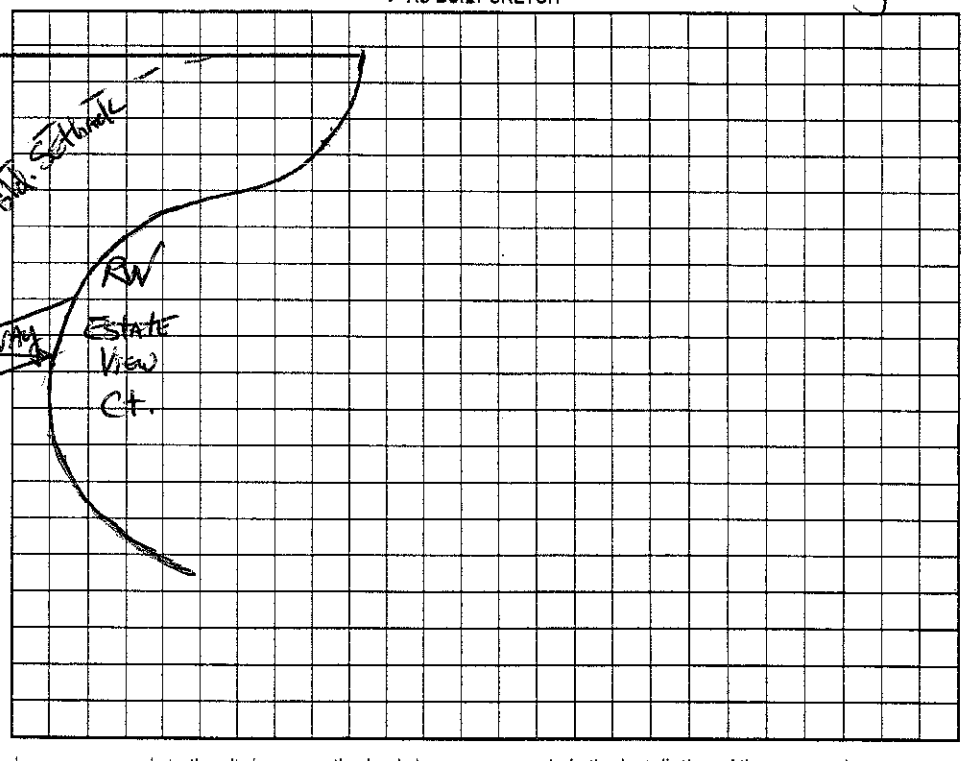

Permit can be suspended or revoked if any false information is supplied toward securing the permit/any unauthorized changes are made to the site/any unauthorized changes are made in the installation of the system. Improvement Permit with plat valid without expiration. Improvement Permit with site plan valid for sixty months. Authorization to Construct is valid for a period equal to that of Improvement Permit – not to exceed sixty months.

Signed: Tony Fell date 10-28-04 Installed by: Christenbury RS

Improvement Permit by: D Hannon RS date 10-8-04 Operation Permit by: Mina H Dolson RS date 8/28/06

Authorization to Construct by: Eric Dawson date 2/22/06 Existing System Inspection by: _____ date _____

HEALTH DEPT. COPY: WHITE OWNER COPY (FINAL): YELLOW OWNER COPY (INITIAL): PINK