IREDELL COUNTY HEALTH DEPARTMENT

STATESVILLE 704-878-5305 MOORESVILLE 704-664-5281

IMPROVEMENT PERMIT / AUTHORIZATION TO CONSTRUCT / OPERATION PERMIT / EXISTING SYSTEM INSPECTION

PERMIT # 158857 PIN # 4636a328056 DATE 11-10-2009

OWNER or APPLICANT Donald Sedgley / Troutman Pools PHONE: Business 528-5162 Home:

OWNER or APPLICANT ADDRESS 168 Comet Trail Statesville, NC 28677

LOCATION / DIRECTIONS Brawley School Rd TL Isle of Pines TL Isle Run TL Preserve Way on left #125

SUBDIVISION Coves @ Chesapeake Pt #1 BLOCK / SECTION LOT # 43 LOT AREA DESIGN FLOW 600 gpd L.T.A.R. .3

Septic Tank 1500 Gallons: STB 338 Date 11/20/06

Pump Tank 1500 Gallons: PT 477 Date 11/27/06

Pump Make Model Serial #

Nitrification Field No Fields 1 No Lines 4 Linear Feet 348

Trench Width 4@ 87' Max. Trench Bottom Depth 36" Gravel Depth N/A

☐ New System ☐ Repair ☐ Expansion System Type I II III IV V VI

System Description: Existing LP-Panel Block

Repair System Description: Same

Maintenance Agreement Required ☐ YES ☐ NO

☐ GRAVITY ☒ PRESSURE

☒ Residence No. Bedrooms 5

☐ Business No. Persons

☐ Other No. Employees

☐ Slab ☐ Crawl Space


☐ Basement w/plumbing ☐ Basement w/o plumbing

Water Supply: ☐ Private ☐ Public ☒ Community

Comments / Conditions: Existing Septic System appears to be functioning Okay at time of inspection. Enclosing existing deck should not impact Septic System.

Comments / Conditions: Septic System installed 4-25-06

INITIAL SITE SKETCH

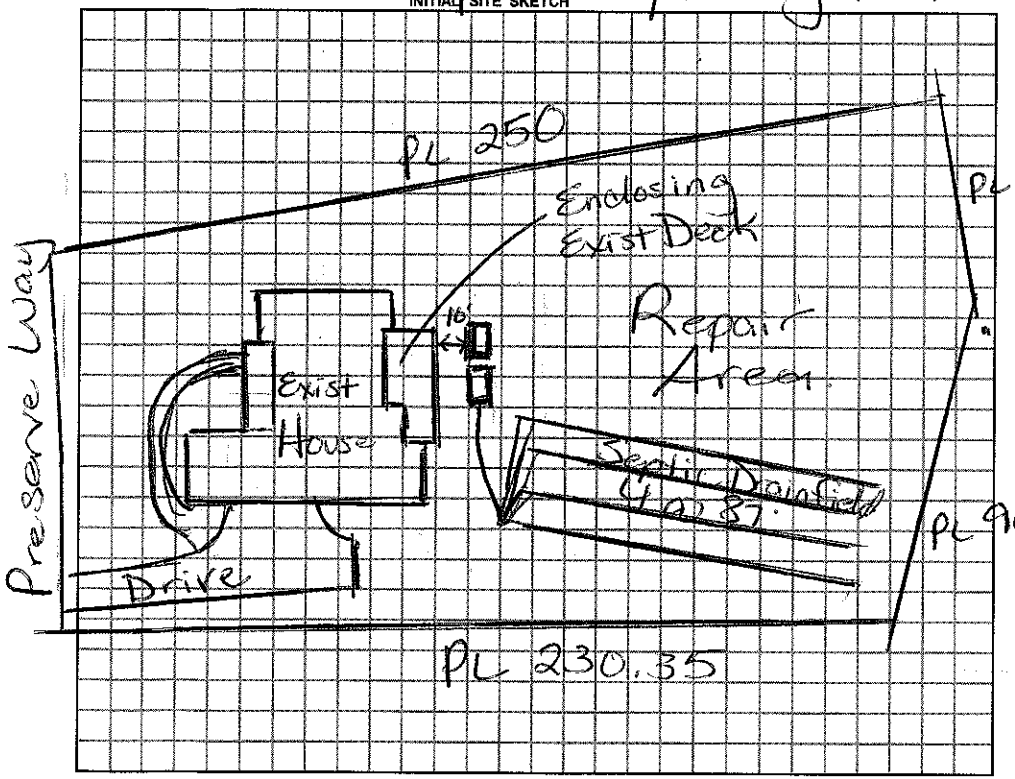

AS BUILT SKETCH

Permit can be suspended or revoked if any false information is supplied toward securing the permit / any unauthorized changes are made to the site / any unauthorized changes are made in the installation of the system.

☐ *IMPROVEMENT PERMIT w / plan valid without expiration.* ☐ *IMPROVEMENT PERMIT w / site plan valid for 60 mos.* ☐ *AUTHORIZATION TO CONSTRUCT valid for period equal to IMPROVEMENT PERMIT-not to exceed 60 mo.*

Owner / Applicant Signature: Donald Sedgley Date 11/12/09

Improvement Permit by: Maria H. Dotson RS Date 11/10/09

Authorization to Construct by: Maria H. Dotson RS Date 11/10/09

YOU SHOULD CONTACT A LOCATOR SERVICE PRIOR TO ANY EXCAVATION.

Installed by:

Operation Permit by: Date:

Existing System Inspected by: Maria H. Dotson RS Date:

WHITE COPY Environmental Health YELLOW COPY (Final) Owner / Applicant PINK COPY (Initial) Owner / Applicant