IREDELL COUNTY HEALTH DEPARTMENT

STATESVILLE 704-878-5305 MOORESVILLE 704-664-5281

IMPROVEMENT PERMIT / AUTHORIZATION TO CONSTRUCT / OPERATION PERMIT / EXISTING SYSTEM INSPECTION

PERMIT# 122287 PIN# ~~4636-32-8622.0427~~ 4636-32-8166 DATE Oct 21, 04

OWNER OR CONTRACTOR Dienst Enterprises (Pine Isle LLC) Orleans PHONE: Business Home

ADDRESS 125 Gaston Dr. Mooresville, NC 28117

LOCATION Brawley Sch Rd TL Isle of Pines TL Isle Run Dr. TL Preserve Way on left at jct w/ Meadow Run Lane

SUBDIVISION The Cove at Chuppah Pt. BLOCK / SECTION LOT 42 LOT AREA .69Ac SITE CLASS. PS DESIGN FLOW 480gpd L.T.A.R. .275-.3

Septic Tank: 1000 Gallons; STB 312 Date 12-23-05

Pump Tank: Gallons; PT Date

Pump Make: Model Serial No.

Nitrification Field: No Fields 1 Square Feet 1260 Linear Feet 420

No Lines 5 Trench Width 36" Max Trench Bottom Depth 36" Gravel Depth NA

☑ New System ☐ Repair System Type: I, II, III, IV, V, VI

System Description: Gravity 25% Reduction

Repair System Description: pm/LP 25% Reduction

Maintenance Agreement Required: ☐ Yes ☑ No

☑ House/Mod. Home No. Bedrooms 4

☐ Mobile Home No. Bathrooms

☐ Business No. Employees

☐ Other


☐ Slab ☑ Crawl Space ☐ Basement w/plumbing ☐ Basement wo/plumbing

Water Supply: ☐ Individual ☑ Public ☑ Community

Comments/Conditions:

Comments/Conditions: 9/12/07 Built deck over ST but can still access it for pumping, footer next to ST but less than 5ft. J

INITIAL SITE SKETCH 1"=50'

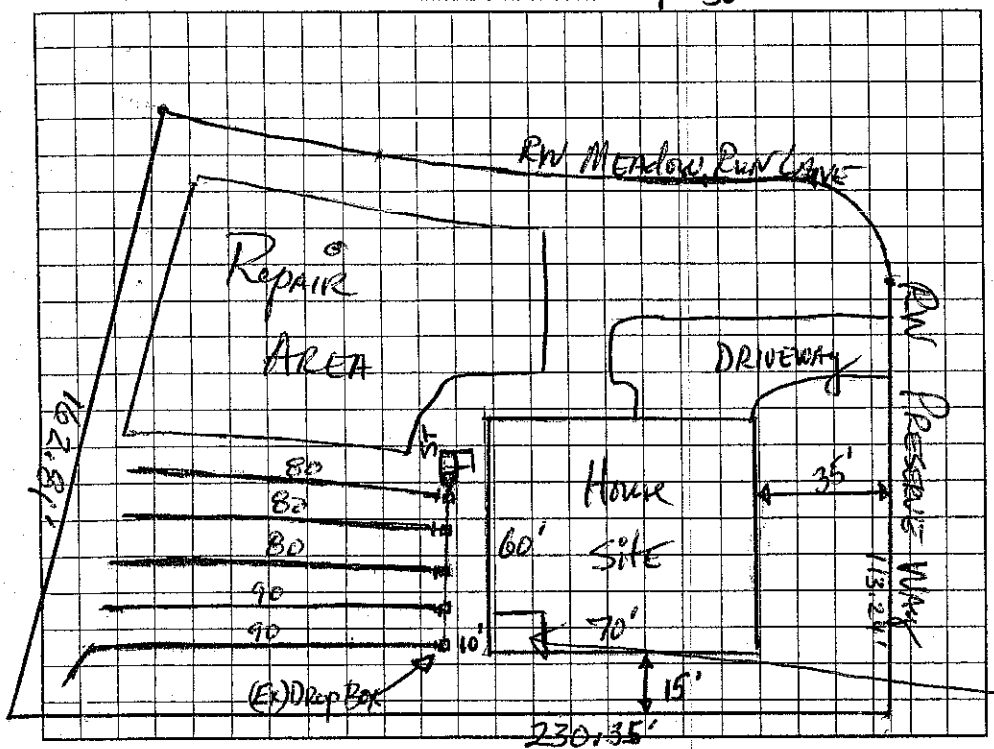

AS BUILT SKETCH

Installed As Drawn Used EZ Flow

The proposed / existing Storage Building addition does not appear to impact the existing septic system.

**NOTE: Must keep at least 5ft from Septic System

~~BEHS~~ Marie Zoberski BEHS

Date: 10/31/11

ICHD-Environmental Health Division

Proposed Storage Building

Permit can be suspended or revoked if any false information is supplied toward securing the permit/any unauthorized changes are made to the site/any unauthorized changes are made in the installation of the system. Improvement Permit with plat valid without expiration. Improvement Permit with site plan valid for sixty months. Authorization to Construct is valid for a period equal to that of Improvement Permit – not to exceed sixty months.

Signed: Tony Pell date 10.28.04

Improvement Permit by: D Hinson RS date 10-21-04

Authorization to Construct by: Judy Merrill date 9-15-05

Installed by: Willie Christenbury RS

Operation Permit by: Marie Zoberski date 2/2/06

Existing System Inspection by: date

HEALTH DEPT. COPY: WHITE OWNER COPY (FINAL): YELLOW OWNER COPY (INITIAL): PINK