IREDELL COUNTY HEALTH DEPARTMENT

STATESVILLE 704-878-5305 MOORESVILLE ...

IMPROVEMENT PERMIT / AUTHORIZATION TO CONSTRUCT / OPERATION PERMIT / EXISTING SYSTEM ... OR

PERMIT# 122287 PIN# ~~4636-32-8692.042~~ 4436-32-8166 DATE Oct 21, 04

OWNER OR CONTRACTOR Diewst Enterprises (Pine Isle LLC) Orleans PHONE: Business Home

ADDRESS 125 Gaston Dr. Mooresville, NC 28117

LOCATION Brawley Sch Rd TL Isle of Pines TL Isle Run Dr. TL Preserve Way on left at jct w/ Meadow Run Cove

SUBDIVISION The Cove at Chiquapin Pt. BLOCK / SECTION LOT 42 LOT AREA .69Ac SITE CLASS PS DESIGN FLOW 480gpd L.T.A.R. .275-.3

Septic Tank: 1000 Gallons; STB 312 Date 12-23-05

Pump Tank: Gallons; PT Date

Pump Make: Model Serial No.

Nitrification Field: No Fields 1 Square Feet 1260 Linear Feet 420

No Lines 5 Trench Width 36" Max Trench Bottom Depth 36" Gravel Depth NA

☑ New System ☐ Repair System Type: I, II, III, IV, V, VI

System Description: Gravity 25% Reduction

Repair System Description: pm/LP 25% Reduction

Maintenance Agreement Required: ☐ Yes ☑ No

☑ House/Mod. Home No. Bedrooms 4

☐ Mobile Home No. Bathrooms

☐ Business No. Employees

☐ Other


☐ Slab ☑ Crawl Space ☐ Basement w/plumbing ☐ Basement wo/plumbing

Water Supply: ☐ Individual ☑ Public ☑ Community


Comments:/Conditions:

Comments:/Conditions: 9/12/07 Built deck over ST but can still access it for pumping, footers next to ST but less than 5ft.

INITIAL SITE SKETCH 1"=50'

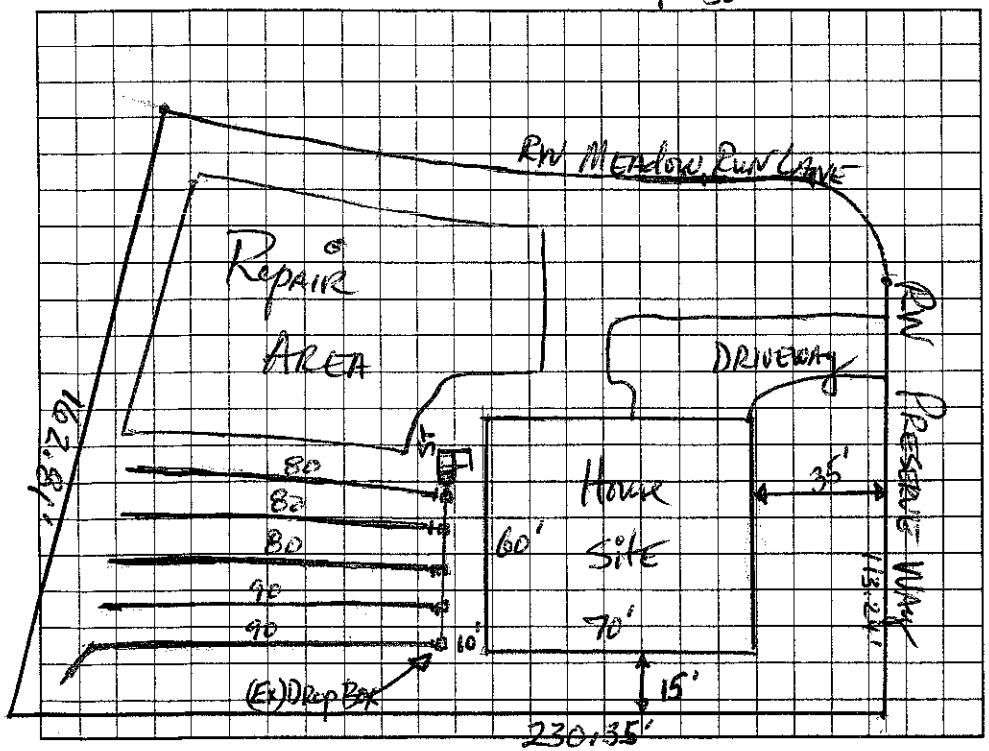

AS BUILT SKETCH

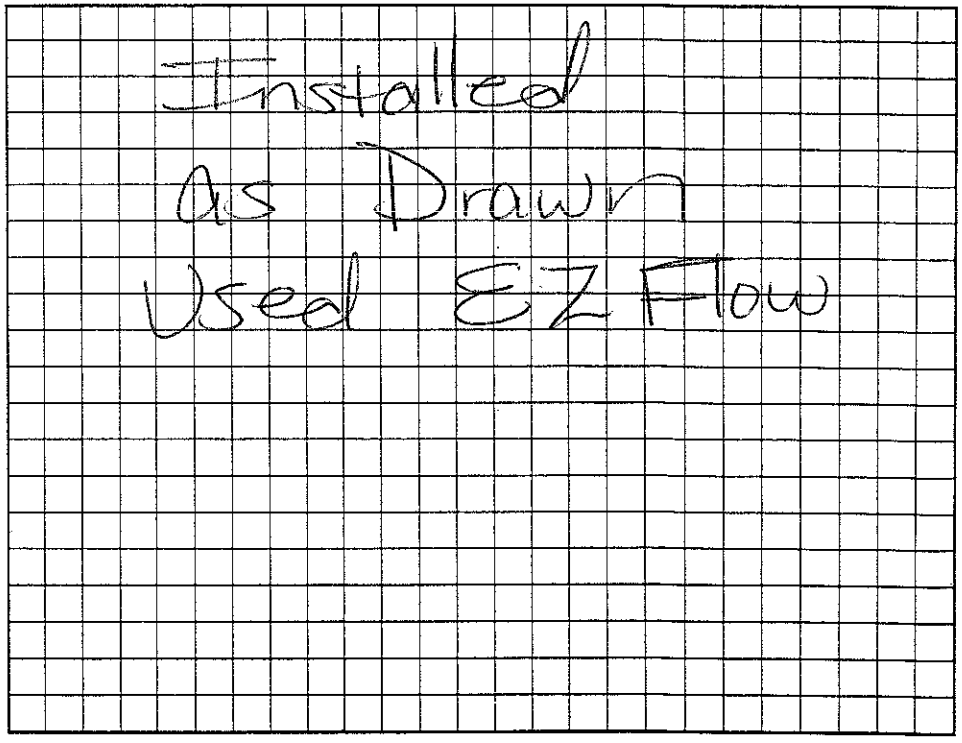

Permit can be suspended or revoked if any false information is supplied toward securing the permit/any unauthorized changes are made to the site/any unauthorized changes are made in the installation of the system. Improvement Permit with plat valid without expiration. Improvement Permit with site plan valid for sixty months. Authorization to Construct is valid for a period equal to that of Improvement Permit – not to exceed sixty months.

Signed: Tony Lee date 10.28.04 Installed by: Willie Christenbury RS

Improvement Permit by: DHsanitarian IRS date 10-21-04 Operation Permit by: Marietta Coleman date 2/2/06

Authorization to Construct by: Judy Merrill date 9-15-05 Existing System Inspection by: date

HEALTH DEPT. COPY: WHITE OWNER COPY (FINAL): YELLOW OWNER COPY (INITIAL): PINK