# IREDELL COUNTY HEALTH DEPARTMENT

STATESVILLE 704-878-5305 MOORESVILLE 704-664-5281

## IMPROVEMENT PERMIT / AUTHORIZATION TO CONSTRUCT / OPERATION PERMIT / EXISTING SYSTEM INSPECTION

PERMIT# 12227 PIN# ~~4636-32-8692.031~~ 4636328356.000 DATE Oct. 13, 04

OWNER OR CONTRACTOR Dienst Enterprises (Pine Isle LLC) / Robert E. PHONE: Business Home

ADDRESS 125 Enston Dr. Mooresville, NC 28117

LOCATION Brawley School TL Isle of Pines TL Isle Run Dr.

SUBDIVISION The Coves at Chesapeake PH BLOCK / SECTION LOT 31 LOT AREA .69 ac SITE CLASS PS DESIGN FLOW 480gpd L.T.A.R. .3

Septic Tank: 1000 Gallons: STB 312 Date 9-1-05

Pump Tank: 1000 Gallons: PT 283 Date 8-1-05

Pump Make: Zoeller Model 152 Serial No.

Nitrification Field: No Fields 1 Square Feet 1200 Linear Feet 400

No Lines 4 Trench Width 36" Max Trench Bottom Depth 36" Gravel Depth NA

☑ New System ☐ Repair System Type: I, II, III, IV, V, VI

System Description: pm 25% Reduction

Repair System Description: LPPPBPS

Maintenance Agreement Required: ☐ Yes ☑ No initially

☐ Slab ☑ Crawl Space ☐ Basement w/plumbing ☐ Basement wo/plumbing

☐ House/Mod. Home No. Bedrooms 4

☐ Mobile Home No. Bathrooms

☐ Business No. Employees

☐ Other


Water Supply: ☐ Individual ~~☐ Public~~ ~~☐ Community~~

Comments:/Conditions:

Comments:/Conditions:

Red Polylok filter, Tank w/risers
Quick 4 chambers installed as initial / jm 9/7/05
Site sketch

1"=50' INITIAL SITE SKETCH

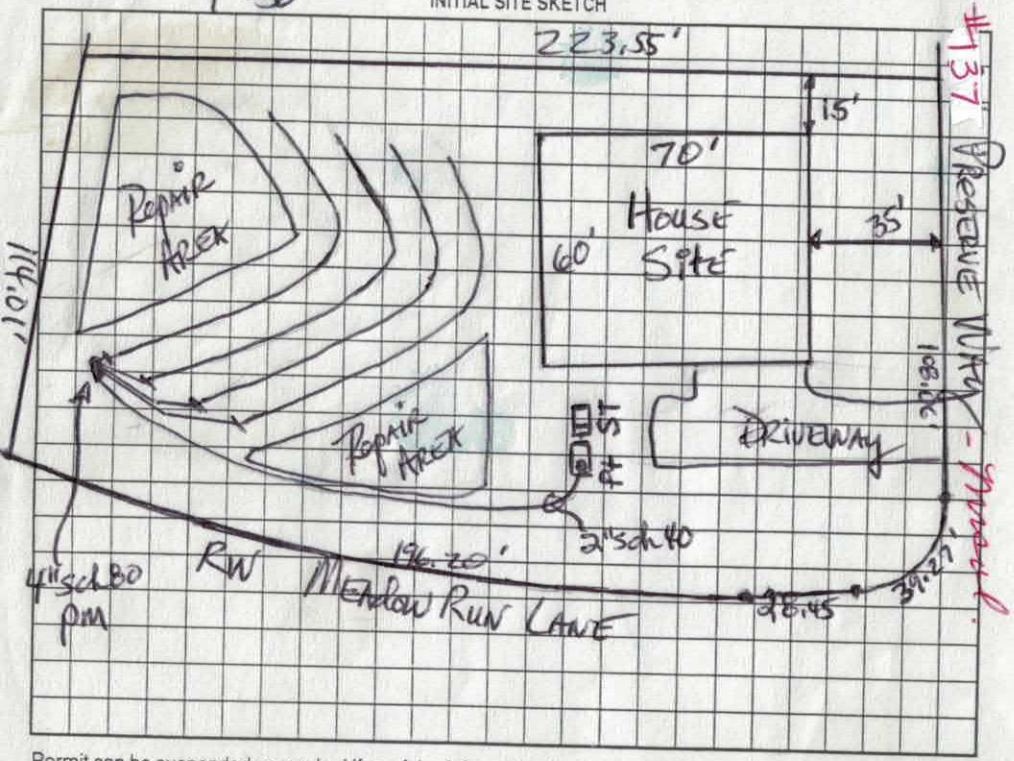


AS BUILT SKETCH

Elect & alarm checked by MD

The proposed / existing POOL addition does not appear to impact the existing septic system.

**NOTE: SEE ATTACHED

Permit #178145

Date: 9-9-05 R.S.

ICHD-Environmental Health Division

ENTERED

Permit can be suspended or revoked if any false information is supplied toward securing the permit/any unauthorized changes are made to the site/any unauthorized changes are made in the installation of the system. Improvement Permit with plat valid without expiration. Improvement Permit with site plan valid for sixty months. Authorization to Construct is valid for a period equal to that of Improvement Permit – not to exceed sixty months.

Signed: Tony Lee date 10.28.04

Improvement Permit by: DR Timmons, RS date 10-13-04

Authorization to Construct by: RS date 2/28/05

Installed by: Willie Christenbury

Operation Permit by: Marian H. Nolan RS date 9/21/05

Existing System Inspection by: date

HEALTH DEPT. COPY: WHITE OWNER COPY (FINAL): YELLOW OWNER COPY (INITIAL): PINK