IREDELL COUNTY HEALTH DEPARTMENT

STATESVILLE 704-878-5305 MOORESVILLE 704-664-5281

IMPROVEMENT PERMIT / AUTHORIZATION TO CONSTRUCT / OPERATION PERMIT / EXISTING SYSTEM INSPECTION

PERMIT# 122264 PIN# ~~4636-32-8692.030~~ → ROBERT ERVIN 4636328478 DATE Oct 13, 04

OWNER OR CONTRACTOR Diewst Enterprises (Pine Isle LLC) PHONE: Business _____ Home _____

ADDRESS 125 Easton Dr, Mooresville, N.C. 28117

LOCATION Brawley School Rd TL Isle of Pines TL Isle of Pines Dr TL Preserve Way on left

SUBDIVISION The Cove at Shoreline PH BLOCK / SECTION _____ LOT 30 LOT AREA .69 Ac SITE CLASS PS DESIGN FLOW 460gpd L.T.A.R. .25-.3

Septic Tank: 1000 Gallons; STB 199 Date 8-2-05
Pump Tank: 1000 Gallons; PT 27 Date 8-2-05
Pump Make: Zoeller Model 152 Serial No. _____
Nitrification Field: No Fields 1 Square Feet 640/960 Linear Feet 320
No Lines 4 Trench Width 24" min 36" Max Trench Bottom Depth 36" Gravel Depth NA

☑ New System ☐ Repair System Type: I, II, III, IV, V, VI
System Description: LPPBPS
Repair System Description: LPPBPS
Maintenance Agreement Required: ☑ Yes ☐ No

☑ House/Mod. Home No. Bedrooms 4
☐ Mobile Home No. Bathrooms _____
☐ Business No. Employees _____
☐ Other _____


☐ Slab ☑ Crawl Space ☐ Basement w/plumbing ☐ Basement wo/plumbing

Water Supply: ☐ Individual ☐ Public ☐ Community

Comments/Conditions: OR 36" min 96" Home turned to face Preserve Way with garage on (L)

Comments/Conditions: Checked tanks, lines & pressure Elect & alarm 9/21/05 MP Used Check Valves in Supply lines to trenches

INITIAL SITE SKETCH 1"=50'

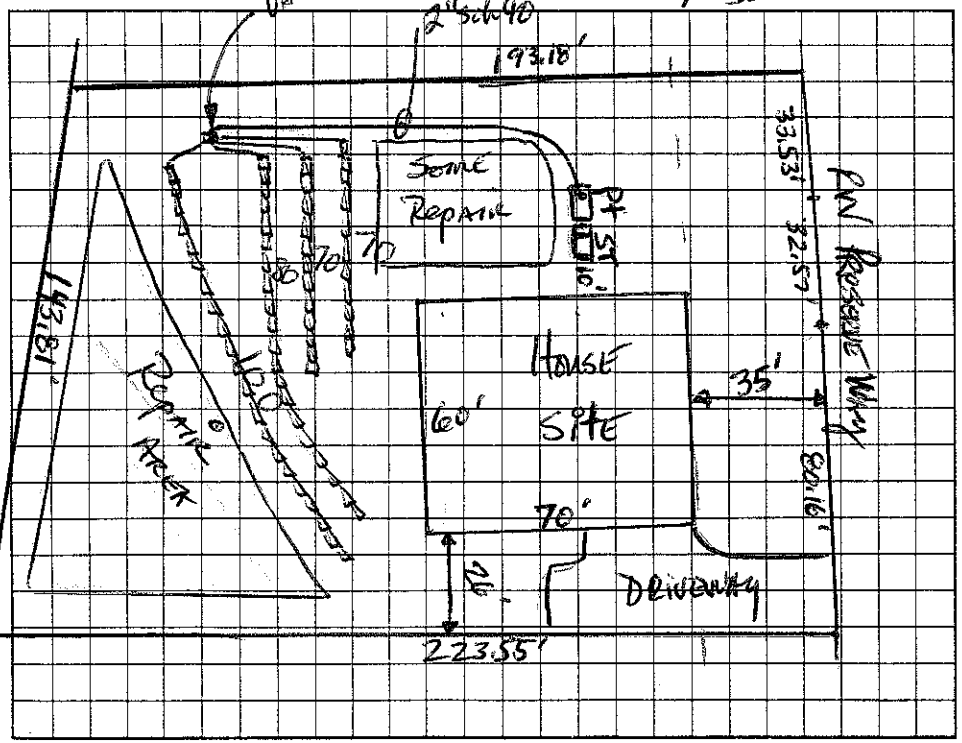

AS BUILT SKETCH

Permit can be suspended or revoked if any false information is supplied toward securing the permit/any unauthorized changes are made to the site/any unauthorized changes are made in the installation of the system. Improvement Permit with plat valid without expiration. Improvement Permit with site plan valid for sixty months. Authorization to Construct is valid for a period equal to that of Improvement Permit – not to exceed sixty months.

Signed: Tony Lee date 10.28.04 Installed by: Willie Christenbury

Improvement Permit by: D. Mathis, RS date 10-13-04 Operation Permit by: Maria H. Dotson RS date 4/25/06

Authorization to Construct by: Wesley Sparks RS date 2/25/05 Existing System Inspection by: _____ date _____

HEALTH DEPT. COPY: WHITE OWNER COPY (FINAL): YELLOW OWNER COPY (INITIAL): PINK