IREDELL COUNTY HEALTH DEPARTMENT

STATESVILLE 704-878-5305 MOORESVILLE 704-664-5281

IMPROVEMENT PERMIT / AUTHORIZATION TO CONSTRUCT / OPERATION PERMIT / EXISTING SYSTEM INSPECTION

PERMIT# 122263 PIN# ~~4636-32-6692.029~~ 4630328663 DATE Oct. 13, 04

OWNER OR CONTRACTOR Drust Enterprises (Pine Isle LLC) / Orleans Builders Business Home

ADDRESS 125 Easton Dr Mooresville NC 28117

LOCATION Brawley Sch Rd TL Isle of Pines TL Isle Run Dr. TL Preserve Way TL Estate View Ct. on left - corner lot

SUBDIVISION The Cove at Chesapeake Pt BLOCK / SECTION LOT 29 LOT AREA .69ac SITE CLASS PS DESIGN FLOW 4 Bdrm L.T.A.R. .03

Septic Tank: 1000 Gallons; STB 312 Date 10-21-05
Pump Tank: 1000 Gallons; PT 27 Date 10-11-05
Pump Make: Myers Model ME 50 Serial No.
Nitrification Field (No) Fields 1 Square Feet 540/810 Linear Feet 270
No Lines 3 Trench Width 24" min 36" o.c. Max Trench Bottom Depth 36" Gravel Depth NA

☑ New System ☐ Repair System Type: I, II, III, (IV), V, VI
System Description: LPPPBPS
Repair System Description: LPPPBPS
Maintenance Agreement Required: ☑ Yes ☐ No


☑ House/Mod. Home No. Bedrooms 4
☐ Mobile Home No. Bathrooms
☐ Business No. Employees
☐ Other
☐ Slab ☑ Crawl Space ☐ Basement w/plumbing ☐ Basement wo/plumbing

Water Supply: ☐ Individual ☑ Public ☐ Community

Comments/Conditions: CR 36" max 9' oc

Comments/Conditions: 5/10/06 3/16" hole drilled Checked tanks, lines & pressure. MD
Checked elect & alarm 6/26/06

INITIAL SITE SKETCH 1"=50'

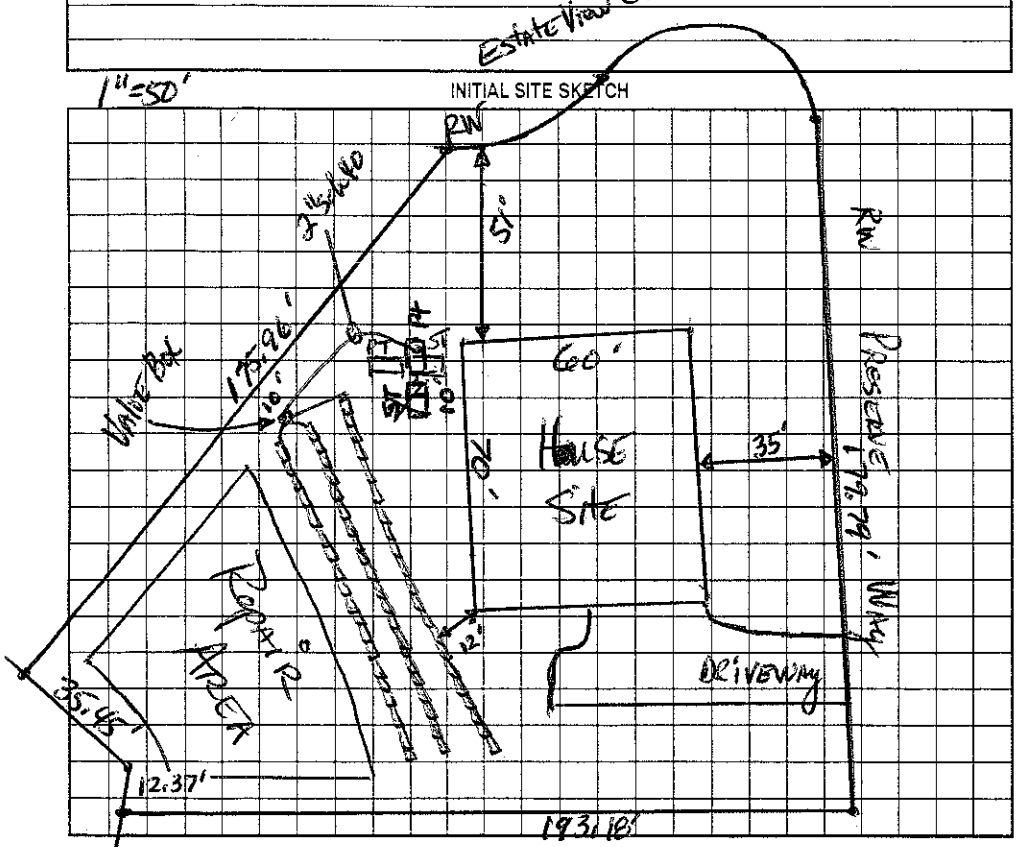

AS BUILT SKETCH

Permit can be suspended or revoked if any false information is supplied toward securing the permit/any unauthorized changes are made to the site/any unauthorized changes are made in the installation of the system. Improvement Permit with plat valid without expiration. Improvement Permit with site plan valid for sixty months. Authorization to Construct is valid for a period equal to that of Improvement Permit – not to exceed sixty months.

Signed: Tony Lee date 10.28.04 Installed by: Willie Christenbury RS

Improvement Permit by: D. Hinson, PS date 10-13-04 Operation Permit by: Maria H. Dotson date 6/26/06

Authorization to Construct by: Wesley Sparks RS date 1/25/06 Existing System Inspection by: date

HEALTH DEPT. COPY: WHITE OWNER COPY (FINAL): YELLOW OWNER COPY (INITIAL): PINK