IREDELL COUNTY HEALTH DEPARTMENT

Statesville Office (704) 878-5305 Mooresville Office (704) 660-3625 PERMIT # 204260

IMPROVEMENT PERMIT / AUTHORIZATION TO CONSTRUCT / OPERATION PERMIT / EXISTING SYSTEM

PIN # 4636 33-0223

APPLICANT: Bonanza Development Co. APPLICANT ADDRESS: 816-G Brawley School Rd Mooresville, NC 28117

SITE ADDRESS: 105 West Vista View Pl Mooresville, NC 28117 PHONE: 704 662 0105 ALT. PHONE: 704 363-9942

SITE DIRECTIONS: Brawley School Rd TL Isle of Pines TL Meadow Crest TL W Vista View on corner


SUBDIVISION: The Villages at Isle of Pines SECTION: LOT # 7 LOT AREA: .07 Ac. DESIGN FLOW: 360 gpd L.T.A.R.: .3

Septic Tank	1000 (gal)	STB 794	Date 12-10-15	☒ New System	☐ Repair	☐ Expansion	System Type: I II III IV V VI	☒ Residence	No. Bedrooms 3	Water Supply
Pump Tank	— (gal)	PT —	Date —	System Description: Gravity - 25% Reduction				☐ Business	No. Persons 6	☐ Private
Pump Make	—	Model —	Serial # —	Repair System Description: Pump/Grav - 25% - 50% Reduct.				☐ Other	No. Employees	☐ Public
# Nitrification Fields	1	# Lines 56	Linear Ft: 300'	Maintenance Agreement Required:	☐ YES	☐ NO		☐ Slab	☒ Crawl Space	☒ Community
Trench Width	36"	Max. Trench Bottom Depth 36"	Gravel Depth N/A		☐ GRAVITY	☐ PRESSURE		☐ Basement w/plumbing	☐ Basement w/o plumbing	


Comments / Conditions:

Notes: Original Septic Evaluation & plan prepared by S&ME dated 6-24-14, Approved 8-3-14

INITIAL SITE SKETCH

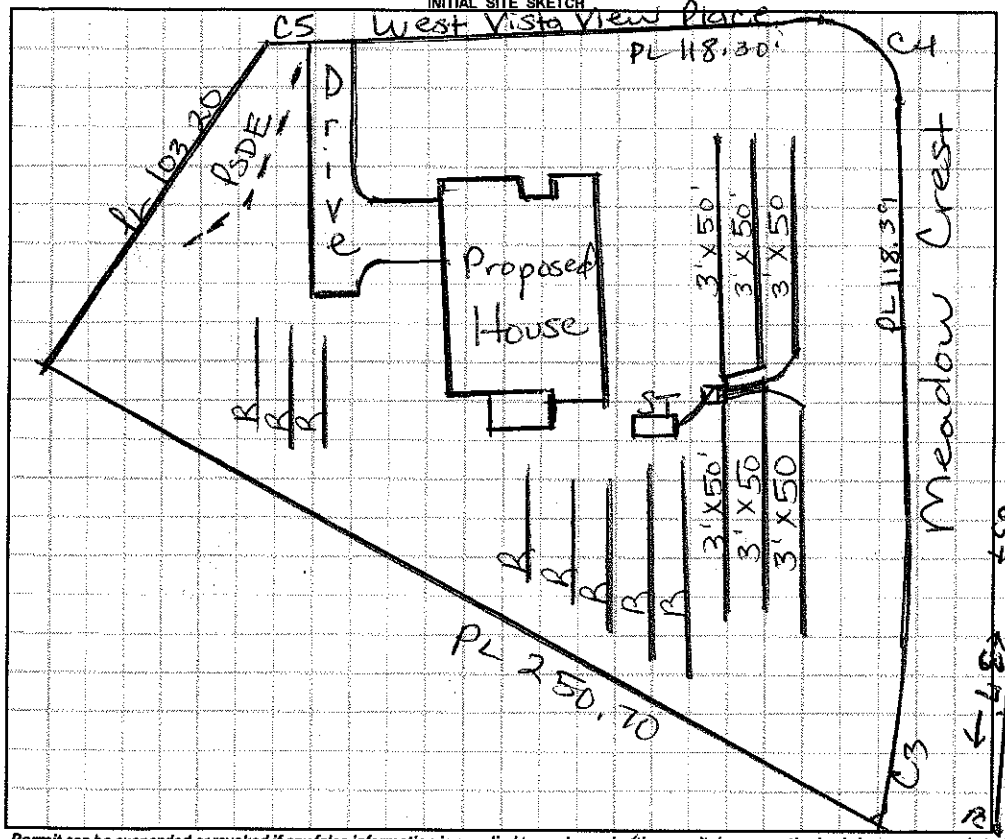

AS BUILT SKETCH

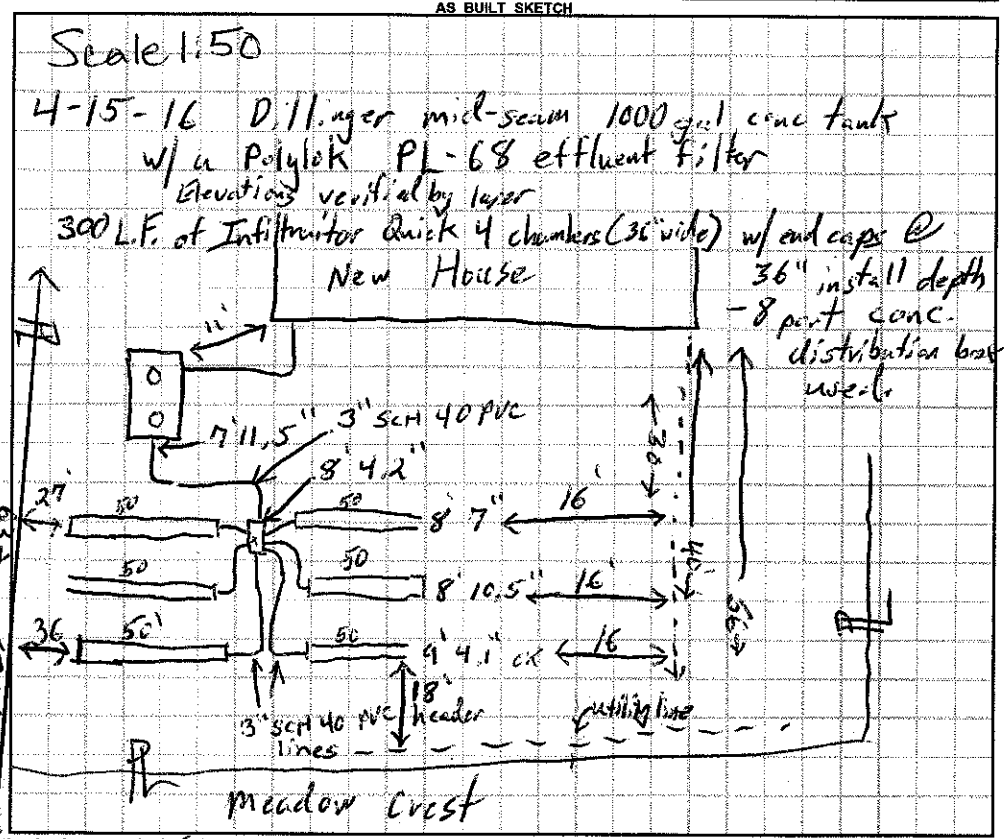

Permit can be suspended or revoked if any false information is supplied toward securing the permit / any unauthorized changes are made to the site / any unauthorized changes are made in the installation of the system. **CONTACT A LOCATOR SERVICE PRIOR TO ANY EXCAVATION**

☐ **IMPROVEMENT PERMIT** *with plat valid without expiration.* ☒ **IMPROVEMENT PERMIT** *with site plan valid for 60 mos.* ☒ **AUTHORIZATION TO CONSTRUCT** *valid for period equal to IMPROVEMENT PERMIT--not to exceed 60 mo.*

Owner / Applicant Signature: Bonanza Development by Scott R. Needham Date: 11/20/15

IMPROVEMENT PERMIT by: Marina Dotson RS Date: 11/19/15

AUTHORIZATION TO CONSTRUCT by: Marina Dotson RS Date: 11/9/15

Installed by: Brad Russell w/ R+H

OPERATION PERMIT by: Tom Shuck Date: 4-15-16

Existing System Inspected by: Date:

Health Dept. Copy - WHITE Applicant (Final Approval) - YELLOW Applicant (Conditional Approval) - PINK