IREDELL COUNTY HEALTH DEPARTMENT

STATESVILLE 704-878-5305 MOORESVILLE 704-664-5281

IMPROVEMENT PERMIT / AUTHORIZATION TO CONSTRUCT / OPERATION PERMIT / EXISTING SYSTEM INSPECTION

PERMIT# 128953 PIN# 4636333208 0570 DATE 6-27-06

OWNER OR APPLICANT Bonanza Development Co. PHONE: Business 704-662-0105 Home 704-363-9947 (cell)

ADDRESS 816-G Brawley School Rd Mooresville 28117

LOCATION Brawley School Rd TL Isle of Pines TL Meadow Crest Ln TL Vista View

SUBDIVISION Villages @ Isle of Pines BLOCK / SECTION ____ LOT 11 LOT AREA .689 Ac SITE CLASS. PS DESIGN FLOW 360gpd L.T.A.R. .25 gpd/ft²

Septic Tank: 1000 Gallons; STB 794 Date 4-14-14
Pump Tank: ____ Gallons; PT ____ Date ____
Pump Make: ____ Model ____ Serial No. ____
Nitrification Field: No Fields 1 Square Feet 1440 Linear Feet 360
No Lines 4 Trench Width 36" Max Trench Bottom Depth 30"

☒ New System ☐ Repair ☐ Expansion System Type: I (II) III IV V VI
System Description: 25% reduction gravity
Repair System Description: LP PPBPS
Maintenance Agreement Required: ☐ Yes ☒ No

☒ House/Mod. Home No. Bedrooms 3
☐ Mobile Home No. Persons 6
☐ Business No. Employees ____
☐ Other ____

Water Supply: ☐ Individual ☐ Public ☒ Community


Gravel Depth NA ☒ Gravity ☐ Pressure ☐ Slab ☒ Crawl Space ☐ Basement w/plumbing ☐ Basement wo/plumbing

Comments:/Conditions: AC Reissued 10-16-13
Shave Berm to allow for gravity system
Use drop boxes for distribution (3)
Redrawn from S&ME plan


Comments:/Conditions:
A Pump system will be required if a gravity system cannot be achieved

1" = 50'

INITIAL SITE SKETCH

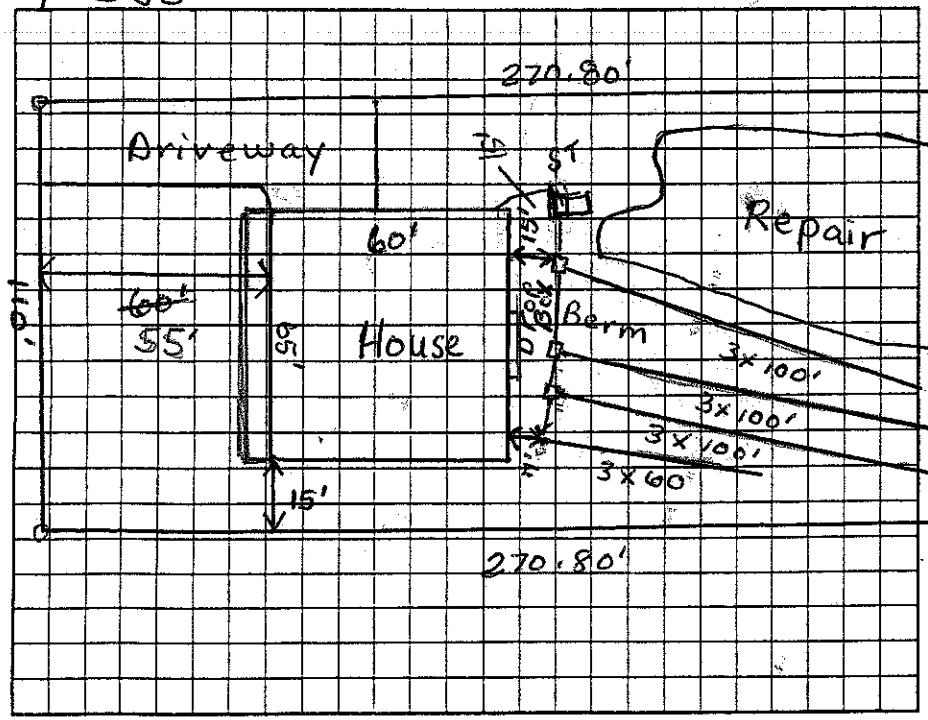

AS BUILT SKETCH

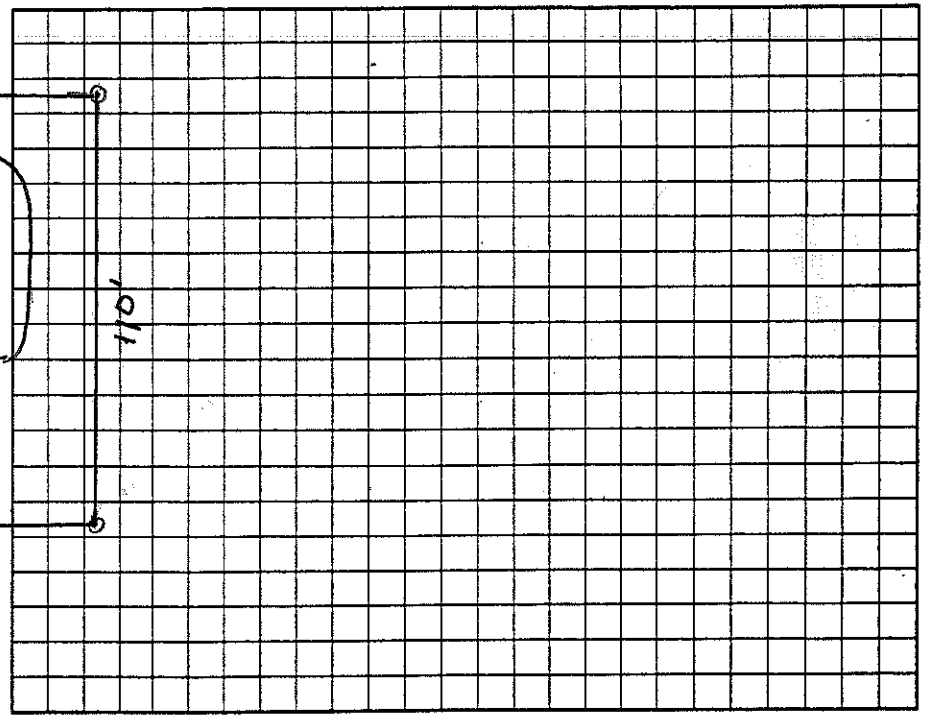

Vista View Place

Permit can be suspended or revoked if any false information is supplied toward securing the permit/any unauthorized changes are made to the site/any unauthorized changes are made in the installation of the system. Improvement Permit with plat valid without expiration. ☐ Improvement Permit with site plan valid for sixty months ☒ Authorization to Construct is valid for a period equal to that of Improvement Permit – not to exceed sixty months.

Signed: Joyce Needham date 6/29/06 Installed by: ____

Improvement Permit by: Judy Melville date 6-27-06 Operation Permit by: [signature] date 5-22-14

Authorization to Construct by: Judy Melville date 6-27-06 Existing System Inspection by: ____ date ____

AC Reissued Judy Melville 10-16-13

HEALTH DEPT. COPY: WHITE OWNER COPY (FINAL): YELLOW OWNER COPY (INITIAL): PINK