IREDELL COUNTY HEALTH DEPARTMENT

STATESVILLE 704-878-5305 / 130.00 Paid MOORESVILLE 704-664-5281 3130

IMPROVEMENT PERMIT / AUTHORIZATION TO CONSTRUCT / OPERATION PERMIT / EXISTING SYSTEM INSPECTION

PERMIT# ~~28960~~ 14976 PIN# 4636 33 3208 .014 4636-33-4409 DATE July 11, 05

OWNER OR CONTRACTOR MIP LLC / Bonanza Dev. Co. PHONE: Business _____ Home _____

ADDRESS 816 G. Brawley School Rd Mooresville, N.C. 28117

LOCATION I-77 - Brawley School Rd - TL Lake of Pines TL Meadow Crest Ln. TR Vista View Pl. 3rd Lot on left - SFE 14A border Tuesday P.M.

SUBDIVISION Village at Lake of Pines BLOCK / SECTION _____ LOT 14/14A LOT AREA .69Ac± .35Ac SFE SITE CLASS PS SFE DESIGN FLOW 360gpd L.T.A.R. .03 SEE 14A

Septic Tank: 1000 Gallons; STB ~~796~~ Date 1-10-08

Pump Tank: 1000 Gallons; PT 283 Date 8-3-08

Pump Make: Gorman Rupp Model ~~WS60-1612~~ Serial No. _____

Nitrification Field: No Fields 1 Square Feet 900 Linear Feet 300

No Lines 3@100' Trench Width 36" Max Trench Bottom Depth 36" Gravel Depth N/A

☒ New System ☐ Repair System Type: I, II, III, IV, V, VI

System Description: PM 25% Reduction on 14A

Repair System Description: LPP4BPS on 14A - 39

Maintenance Agreement Required: ☐ Yes ☒ No Normally

☒ House/Mod. Home ☐ Mobile Home ☐ Business ☐ Other

No. Bedrooms 3 No. Bathrooms _____ No. Employees _____

☐ Slab ☒ Crawl Space ☐ Basement w/plumbing ☐ Basement wo/plumbing

Water Supply: ☐ Individual ☒ Public ☒ Community


Comments:/Conditions:

System designed and site evaluated by Paul Pennington of S&ME.
House and tank elevations* to be provided to this department prior to issuance of an Authorization to Construct.


Comments:/Conditions: Supply Line - Green Pipe Gm 1/10/06

10/8/08 Checked tanks & 1st drainline.

INITIAL SITE SKETCH * elevations with Respect to off-site Septic field(s).

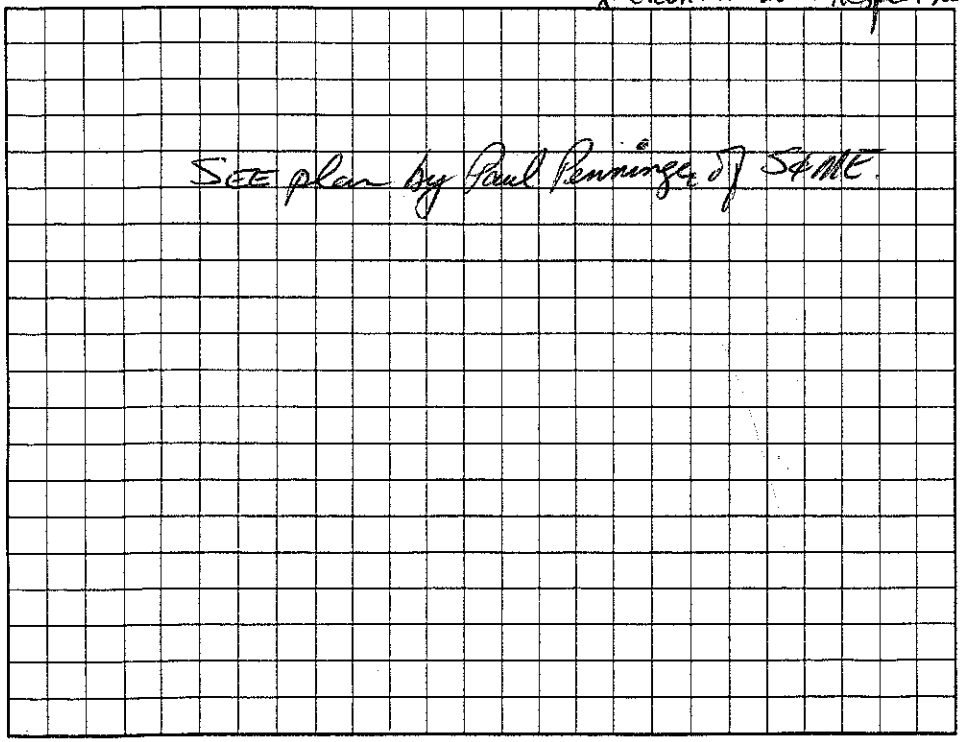

AS BUILT SKETCH

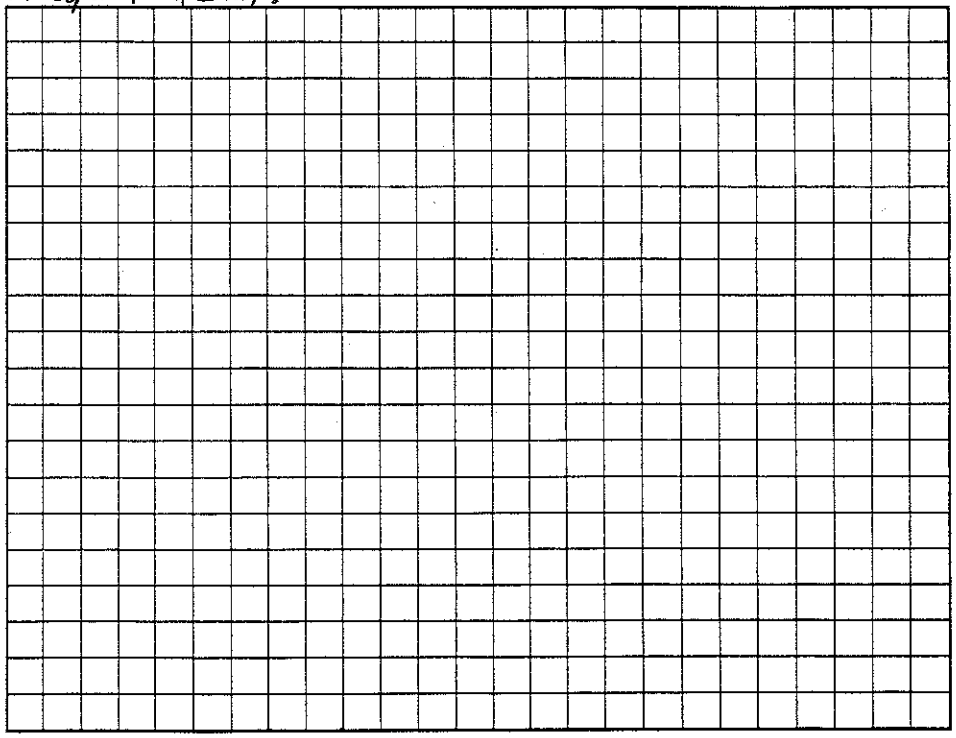

Permit can be suspended or revoked if any false information is supplied toward securing the permit/any unauthorized changes are made to the site/any unauthorized changes are made in the installation of the system. Improvement Permit with plat valid without expiration. Improvement Permit with site plan valid for sixty months. Authorization to Construct is valid for a period equal to that of Improvement Permit – not to exceed sixty months.

Signed: Bonanza Dev. Co. by Scott L. Medlin date 7/15/05

Improvement Permit by: [signature] RS date 7-11-05

Authorization to Construct by: Wesley Sparks RS. date 3/20/07

Installed by: F&T Excavating

Operation Permit by: Wesley Sparks RS. date 11/6/08

Existing System Inspection by: _____ date _____

HEALTH DEPT. COPY: WHITE OWNER COPY (FINAL): YELLOW OWNER COPY (INITIAL): PINK

LOT 14
VILLAGES AT ISLE OF PINES
SCALE: 1" = 50'

...ION
...TER SECTION

Lot 27 is sm...
Lot 28 is well lot, lo...

PROPOSED SITE PLAT LOT 14

