...LL COUNTY HEALTH DEPARTMENT / Authorization to Construct 4036335123

STATESVILLE 704-878-5305 MOORESVILLE 704-664-5281

...PROVEMENT PERMIT / ~~CERTIFICATE OF COMPLETION~~ / OPERATION PERMIT / EXISTING SYSTEM INSPECTION

PROPERTY DESCRIPTION NO. 25528 DATE 12/10/96 TAX MAP NO. 2G A 21 Watershed: ☐ Yes ☒ No

OWNER OR CONTRACTOR Hal W. Murdock PHONE: Business _____ Home 664-6026

ADDRESS 190 Turkyfield Rd. Mooresville, NC 28115

LOCATION Brawley Sch. TL Sale Pines TL on Turkyfield Rd. on (L) just before brick house

SUBDIVISION N/A BLOCK / SECTION _____ LOT _____ LOT AREA 111.34 SITE CLASS: PS DESIGN FLOW 360 L.T.A.R. .3

Septic Tank: 1000 Gallons; STB _____ Date 11/6/96

Pump Tank: _____ Gallons; PT _____ Date _____

Pump Make: _____ Model _____ Serial No. _____

Nitrification Field: No Fields 1 Square Feet 1200 Linear Feet 400

No Lines 4 Trench Width 36" Max Trench Bottom Depth 36" Gravel Depth 12"

☒ New System ☐ Repair System Type: I (II) III, IV, V, VI

System Description: CONV - DROP BOX

Repair System Description: SAME

Maintenance Agreement Required: ☐ Yes ☐ No

☒ House/Mod. Home No. Bedrooms 3

☐ Mobile Home No. Bathrooms 2

☐ Business No. Employees _____

☐ Other _____


☐ Slab ☒ Crawl Space ☐ Basement w/plumbing ☐ Basement wo/plumbing

Water Supply:
☒ Individual
☐ Community
☐ Public


Comments:
115
90
100

Comments:

INITIAL SITE SKETCH

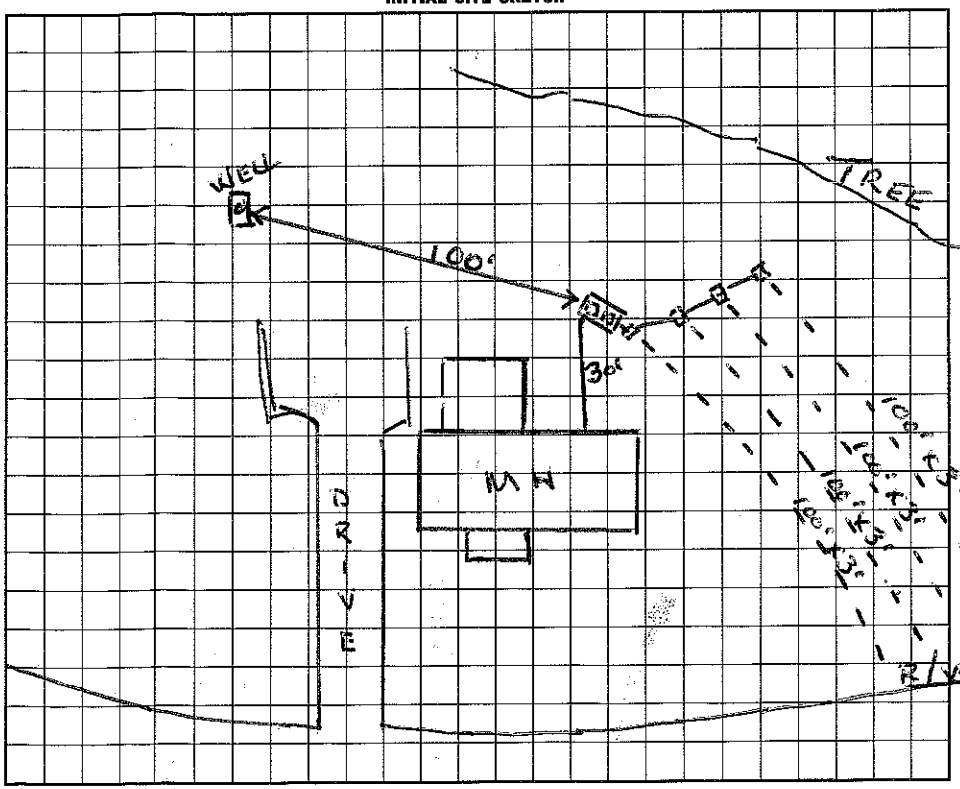

AS BUILT SKETCH

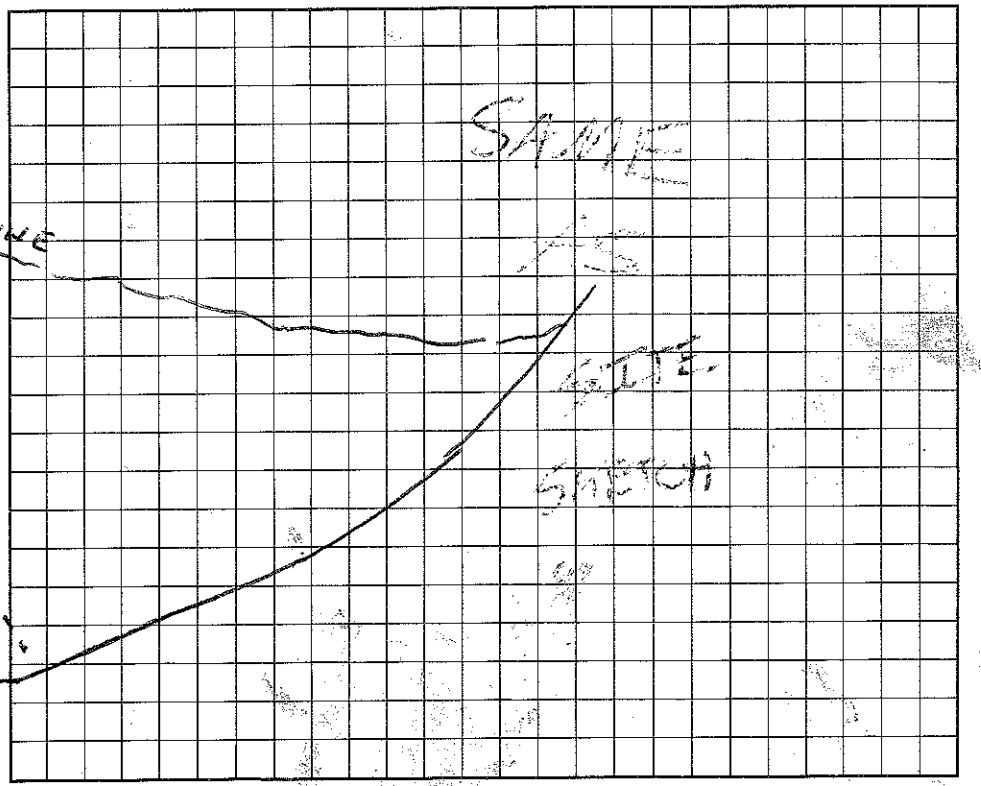

I understand that this permit can be suspended or revoked if any false information is supplied toward securing the permit/any unauthorized changes are made to the site/any unauthorized changes are made in the installation of the system.

Signed: Hal W. Murdock

Improvement Permit by: Wesley Sparks RS. date 12/10/96

~~Authorization to Construct by:~~ Wesley Sparks RS. date 12/10/96

Installed by: FOREST SHORES

Certificate of Completion by: _____ date _____

Operation Permit by: [signature] date 3/26/97

HEALTH DEPT. COPY: WHITE INSPECTION COPY (FINAL): GREEN OWNER COPY (FINAL): YELLOW INSPECTION COPY (INITIAL): PINK OWNER COPY (INITIAL): GOLD