Old # 128965

IREDELL COUNTY HEALTH DEPARTMENT

Statesville Office (704) 878-5305 Mooresville Office (704) 660-3625 PERMIT # 204350

IMPROVEMENT PERMIT / AUTHORIZATION TO CONSTRUCT / OPERATION PERMIT / EXISTING SYSTEM

PIN # 4636-33-7341

APPLICANT: Bonanza Dev. Co. APPLICANT ADDRESS: 816-G Brawley Sch Rd Mooresville NC 28117

SITE ADDRESS: 126 E. Vista View Place - Mod. PHONE: 704-662-0105 ALT. PHONE: 704-363-9942

SITE DIRECTIONS: Brawley Sch Rd, TL on Isle of Pines, TR on Meadow Crest, TR on E. Vista View, Lot ~~6~~ 18 at end

SUBDIVISION: The Villages at Isle of Pines SECTION: — LOT # 18 LOT AREA: 0.71 ac DESIGN FLOW: 360 gpd L.T.A.R.: 0.3

Septic Tank 1000 (gal) STB 794 Date 9-14-16
Pump Tank (gal) PT Date
Pump Make Model Serial #
Nitrification Fields 1 # Lines 4 Linear Ft: 300'
Trench Width 36" Max. Trench Bottom Depth 36" Gravel Depth N/A

☑ New System ☐ Repair ☐ Expansion System Type: I II (III) IV V VI
System Description: Gravity 25% Reduction
Repair System Description: LPP PBPS
Maintenance Agreement Required: ☐ YES ☑ NO
☑ GRAVITY ☐ PRESSURE

☑ Residence No. Bedrooms 3
☐ Business No. Persons 6
☐ Other No. Employees
☐ Slab ☑ Crawl Space
☐ Basement w/plumbing ☐ Basement w/o plumbing

Water Supply: ☐ Private ☐ Public ☑ Community

Comments / Conditions:

ST - 13.2ft off house (1.5 From Bay)

INITIAL SITE SKETCH

SEE DESIGN BY S & ME

(Dated 6-26-14, Approved 8-8-14)

AS BUILT SKETCH

Installed Quick 4 essentially as drawn.

Permit can be suspended or revoked if any false information is supplied toward securing the permit / any unauthorized changes are made to the site / any unauthorized changes are made in the installation of the system. CONTACT A LOCATOR SERVICE PRIOR TO ANY EXCAVATION

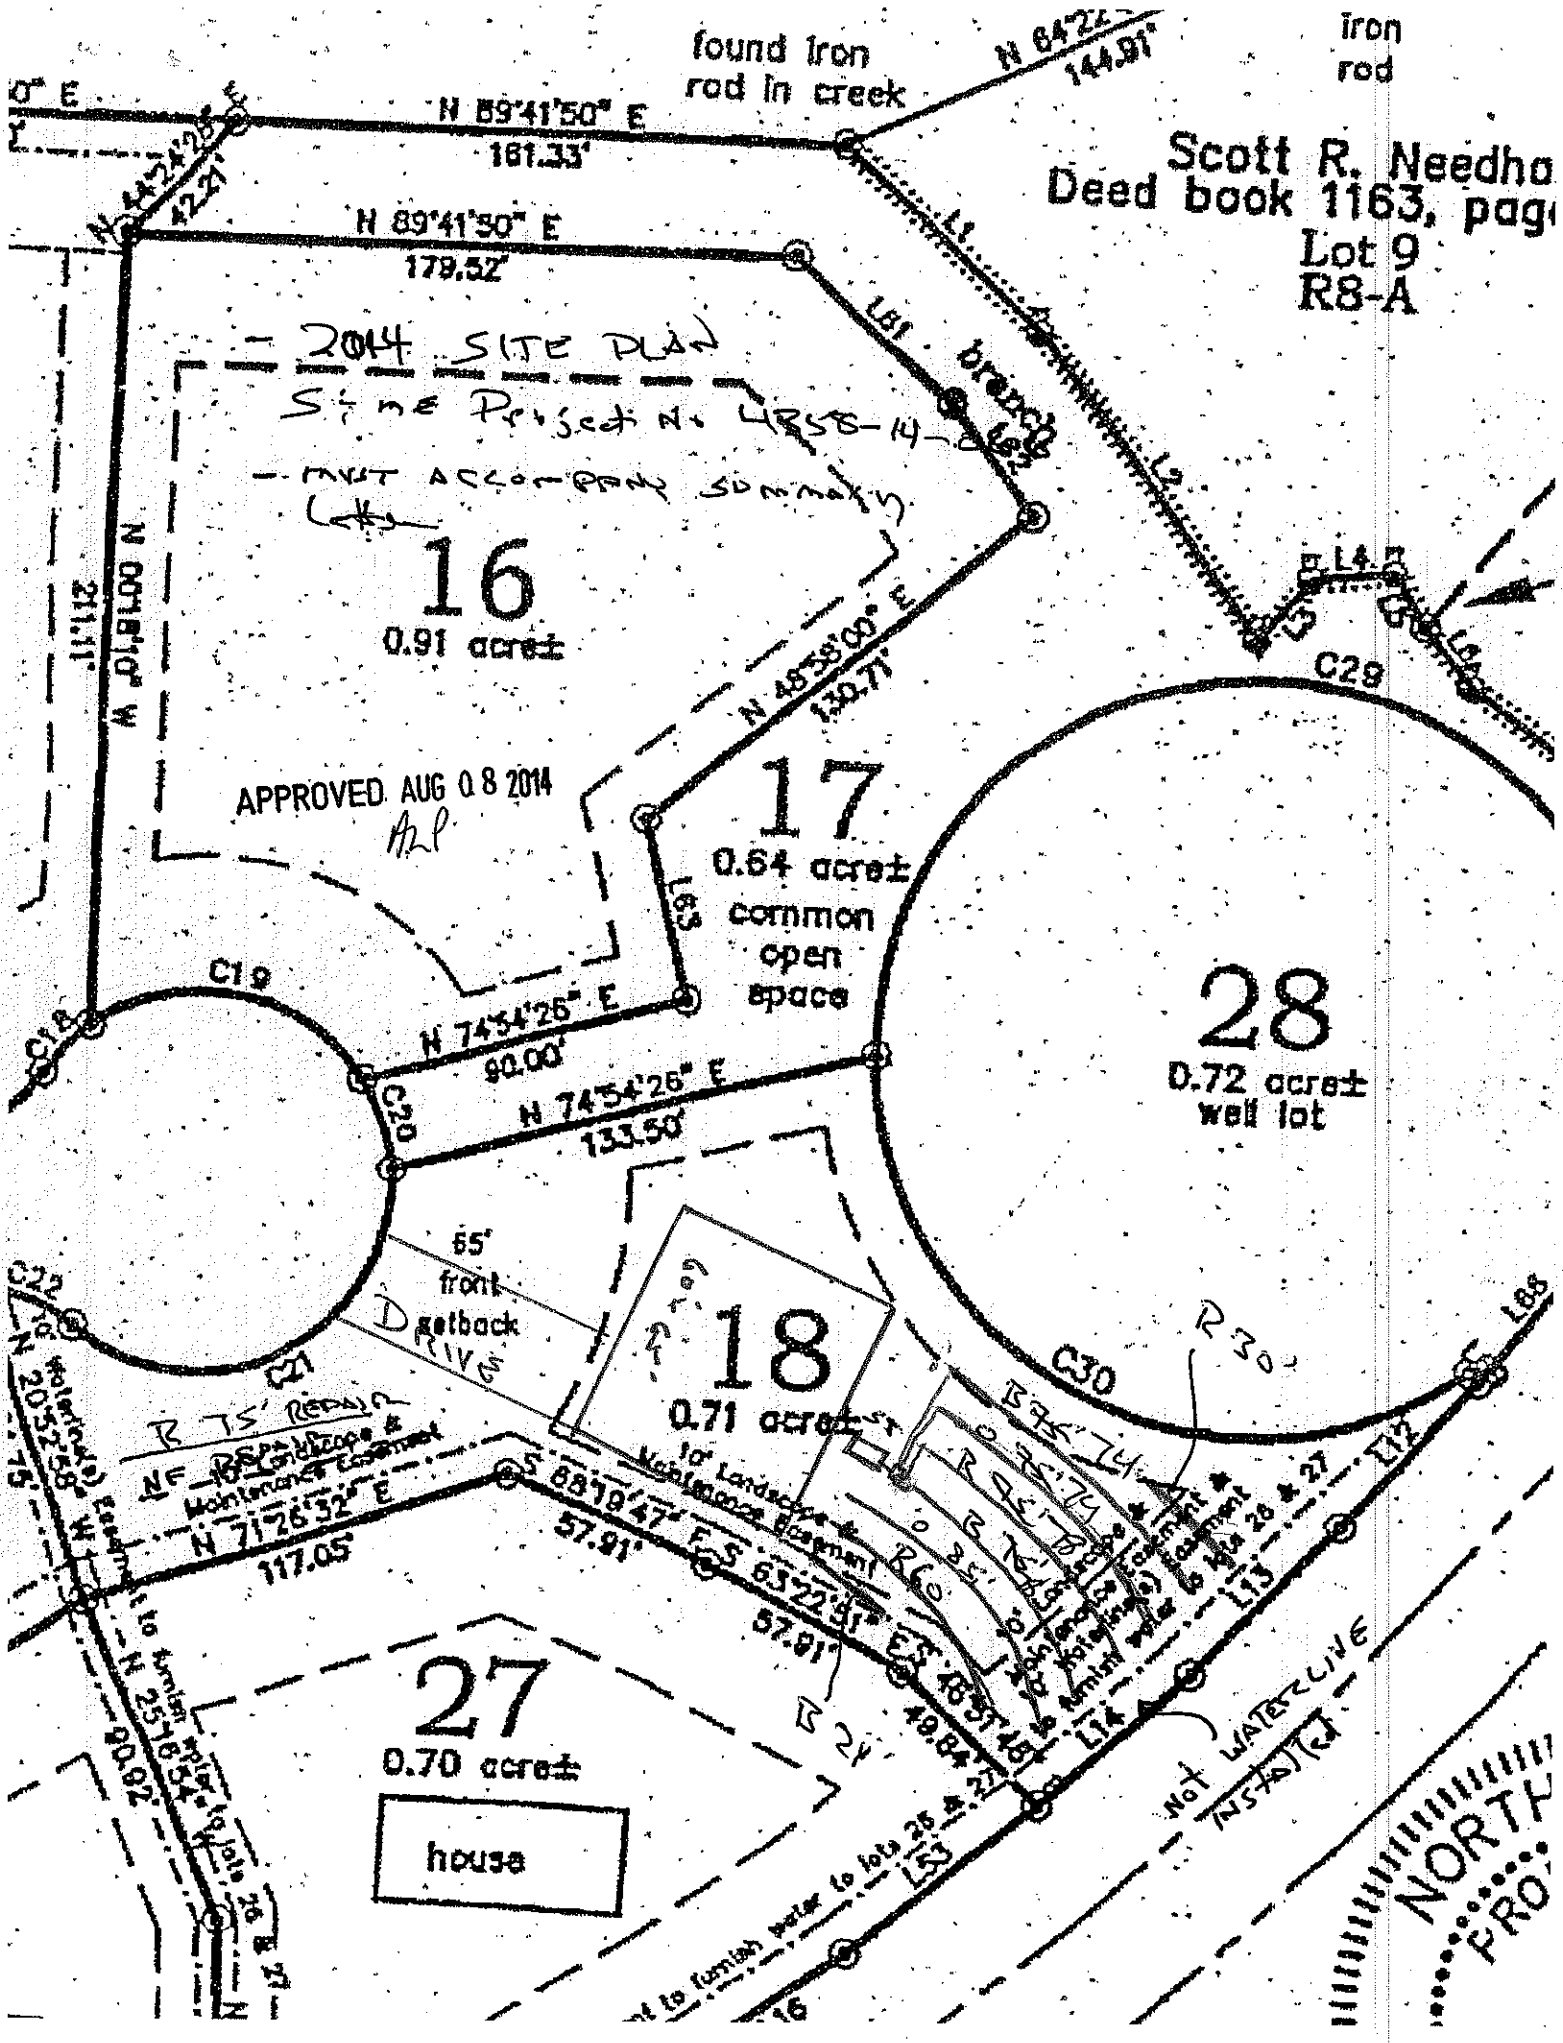
☑ IMPROVEMENT PERMIT *with plat* valid without expiration. ☒ IMPROVEMENT PERMIT *with site plan* valid for 60 mos. ☒ AUTHORIZATION TO CONSTRUCT valid for period equal to IMPROVEMENT PERMIT--not to exceed 60 mo.

Owner / Applicant Signature: Scott R. Needham Date: 8/13/14 Installed by: R&H

IMPROVEMENT PERMIT by: Date: 8-8-14 OPERATION PERMIT by: Maria Dolan RS. Date: 10/19/16

AUTHORIZATION TO CONSTRUCT by: Date: 3-28-16 Existing System Inspected by: Date:

Health Dept. Copy - WHITE Applicant (Final Approval) - YELLOW Applicant (Conditional Approval) - PINK


found iron rod in creek
iron rod
N 89°41'50" E
181.33'
N 64°22'
144.91'
Scott R. Needha
Deed book 1163, pag
Lot 9
R8-A
2014 SITE PLAN
Site Project No. 4858-14-2
- MUST ACCOMPANY SUBMITTAL
16
0.91 acre±
N 89°41'50" E
179.52'
N 44°24'25" E
42.21'
N 00°18'10" W
211.11'
N 48°38'00" E
120.71'
APPROVED AUG 08 2014
17
0.64 acre±
common open space
28
0.72 acre±
well lot
N 74°54'26" E
90.00'
N 74°54'26" E
133.50'
65' front setback
18
0.71 acre±
27
0.70 acre±
house
N 71°26'32" E
117.05'
S 88°18'47" E
57.91'
S 65°22'51" E
57.81'
S 45°51'48" E
49.84'
10' Landscape & Maintenance Easement
Not WATERLINE INSTALLED
NORTH
C18
C19
C20
C21
C22
C28
C30
L1
L2
L3
L4
L5
L6
R30'
R24'
R60'