IREDELL COUNTY HEALTH DEPARTMENT

STATESVILLE 704-878-5305 MOORESVILLE 704-664-5281 200

IMPROVEMENT PERMIT / AUTHORIZATION TO CONSTRUCT / OPERATION PERMIT / EXISTING SYSTEM INSPECTION

PERMIT# 122251 PIN# ~~4636-32-8612 1025~~ 4630338020 DATE Oct 8, 04

OWNER OR CONTRACTOR Dienst Enterprises (Pine Isle LLC) / Robert Ervin PHONE: Business ______ Home ______

ADDRESS 125 Easton Dr. Mooresville NC 28117

LOCATION Brawley Sch Rd TL Isle of Pines TL Isle Run Dr. TL Preserve Way at end on left

SUBDIVISION The Cove at Champeden Pt BLOCK / SECTION ______ LOT 25 LOT AREA .77Ac SITE CLASS. PS0 DESIGN FLOW 480gpd L.T.A.R. .3

Septic Tank: 1000 Gallons; STB 794 Date 1-6-06
Pump Tank: 1000 Gallons; PT 283 Date 9-30-05
Pump Make: Myers Model ME 50 Serial No. ______
Nitrification Field: No. Fields 1 Square Feet 540/810 Linear Feet 270
No Lines 4 Trench Width 24" min 8'oc* Max Trench Bottom Depth 36" Gravel Depth NA

☑ New System ☐ Repair System Type: I, II, III, (IV), V, VI
System Description: LPP PBPS
Repair System Description: LPP PBPS
Maintenance Agreement Required: ☑ Yes ☐ No
☐ Slab ☑ Crawl Space ☐ Basement w/plumbing ☐ Basement wo/plumbing


☑ House/Mod. Home No. Bedrooms 4
☐ Mobile Home No. Bathrooms ______
☐ Business No. Employees ______
☐ Other ______

Water Supply:
☐ Individual
☑ Public
☑ Community

Comments:/Conditions: Do NOT cut / Lower House site!
* 36" max 9' o c trench width.
"Shave off" old burms in septic system AREA.

Comments:/Conditions: 4/6/06 Checked tanks, lines & pressure
Drilled 3/16" holes
Alarm elect 5/22/06

INITIAL SITE SKETCH 1"=50'

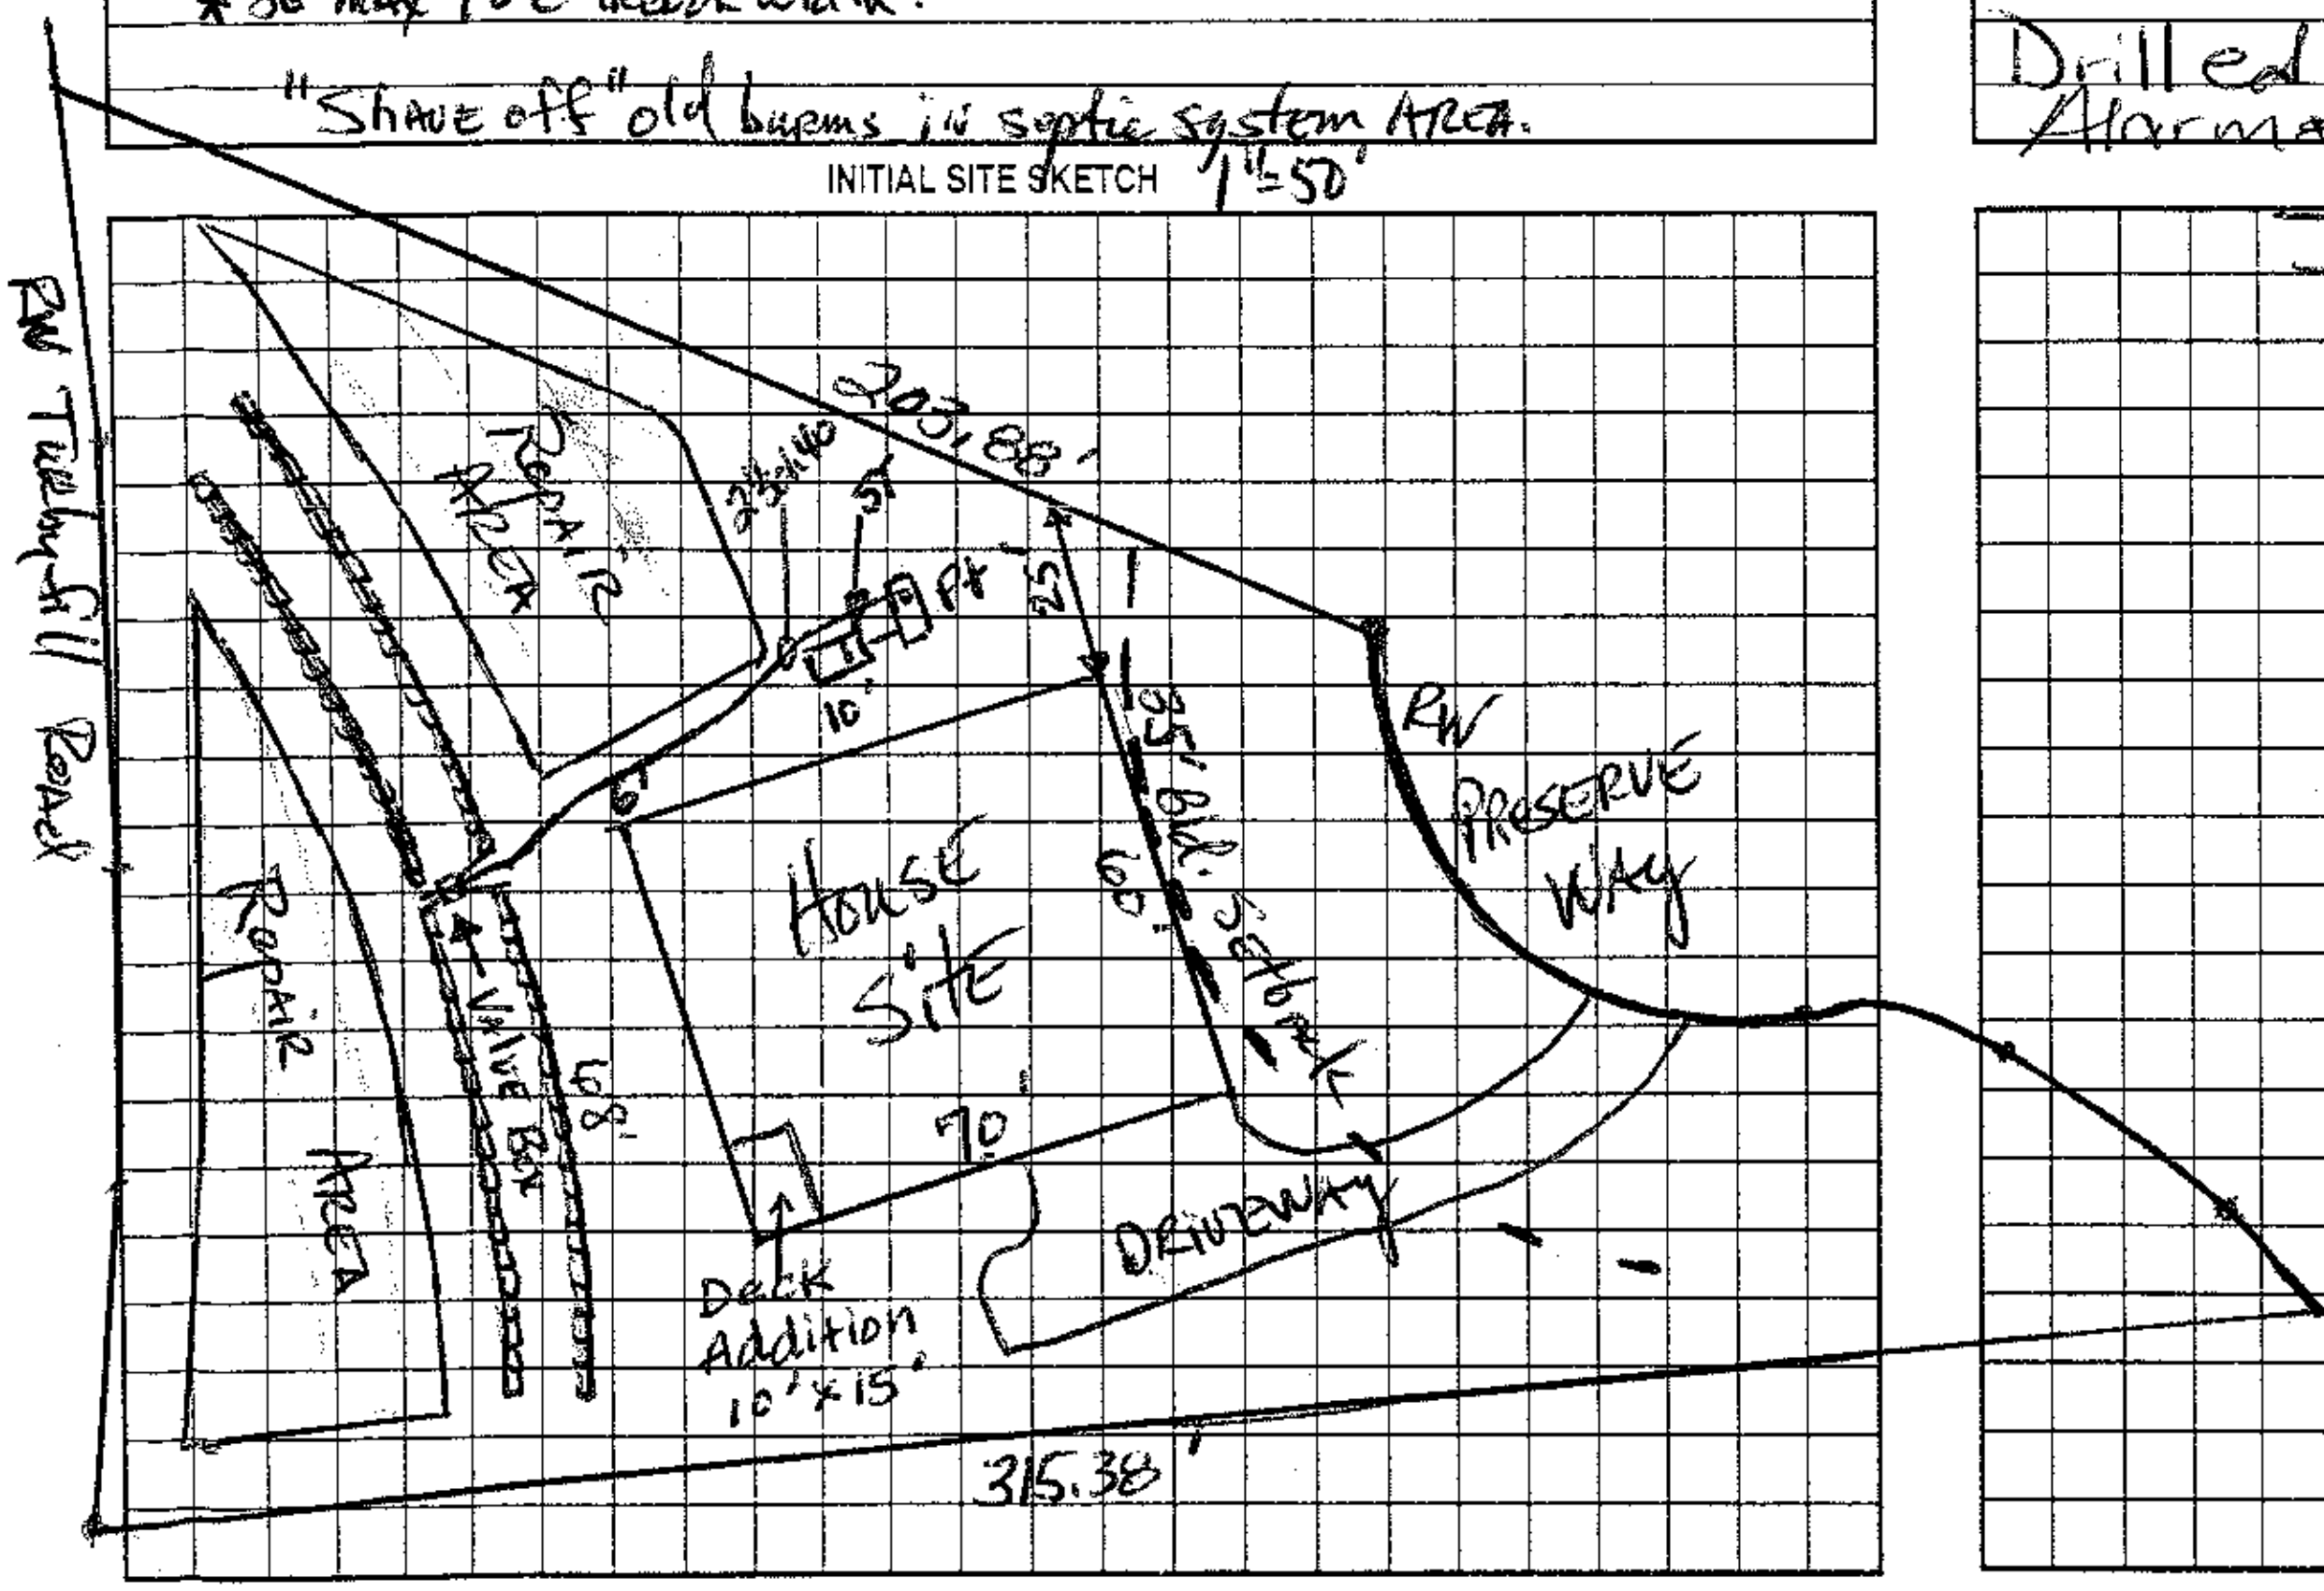

AS BUILT SKETCH

Installed as Shown

The location of the proposed Deck Addition addition does not appear to impact the existing septic system.
**NOTE: ______

Judy Melville REHS
Date: 3-22-11
ICHD-Environmental Health Division

Permit can be suspended or revoked if any false information is supplied toward securing the permit/any unauthorized changes are made to the site/any unauthorized changes are made in the installation of the system. Improvement Permit with plat valid without expiration. Improvement Permit with site plan valid for sixty months. Authorization to Construct is valid for a period equal to that of Improvement Permit – not to exceed sixty months.

Signed: Tony Lee date 10-28-04
Improvement Permit by: [signature] RS date 10-8-04
Authorization to Construct by: [signature] RS date 11/14/05

Installed by: Willie Christenbury
Operation Permit by: [signature] RS date 5/22/06
Existing System Inspection by ______ date ______

HEALTH DEPT. COPY: WHITE OWNER COPY (FINAL): YELLOW OWNER COPY (INITIAL): PINK