IREDELL COUNTY HEALTH DEPARTMENT

STATESVILLE 704-878-5305 MOORESVILLE 704-664-5281

IMPROVEMENT PERMIT / AUTHORIZATION TO CONSTRUCT / OPERATION PERMIT / EXISTING SYSTEM INSPECTION

PERMIT# 070308 PIN# [redacted] 4636344164 (pt) 4636 33 9509 DATE Feb 20, '98

OWNER OR CONTRACTOR Bonanza Dev. Co. PHONE: Business 662-0105 Home

ADDRESS 816 G Brawley Sch Rd, Mooresville

LOCATION Brawley Sch Rd. TL Shutts Rd. TR Turby-hill Rd. on Right SFE

SUBDIVISION Turby-hill Pines BLOCK / SECTION LOT 9 LOT AREA SFE ~137'x223' SITE CLASS. PS DESIGN FLOW 480gpd L.T.A.R. no. 3

Septic Tank: 1500 Gallons; STB 338 Date 6/15/99

Pump Tank: 1500 Gallons; PT 336 Date 6/22/99

Pump Make: MYERS Model P102 Serial No 25345 Dec 12

Nitrification Field: No Fields 1 Square Feet 1200 Linear Feet 400

No Lines 4@100' Trench Width 36" Max Trench Bottom Depth ~30" Gravel Depth NA

☑ New System ☐ Repair System Type: I, II, III, IV, V, VI

System Description: Pumped-pm-Modified 25% Reduction

Repair System Description: LP Panel Block

Maintenance Agreement Required: ☐ Yes ☑ No initially

☐ House/Mod. Home ☑ Mobile Home ☐ Business ☑ Other Duplex Apt.

No. Bedrooms 4 No. Bathrooms 5 No. Employees


☑ Slab ☐ Crawl Space ☐ Basement w/plumbing ☐ Basement wo/plumbing

Water Supply: ☑ Individual ☐ Public ☐ Community


Comments:/Conditions: * ONE inspection/observation port per lateral, Remove old Berms/Terraces where specified. Create New Berm where shown. Approximately 1100' from pump tank to SFE #9. If 2" sch 40 supply line is used, friction loss will be approx 20', Therefore 3" sch 40 is Recommended.

Comments:/Conditions: See State Sewage Rules Regarding pump line specifications on crossing Creek.

INITIAL SITE SKETCH

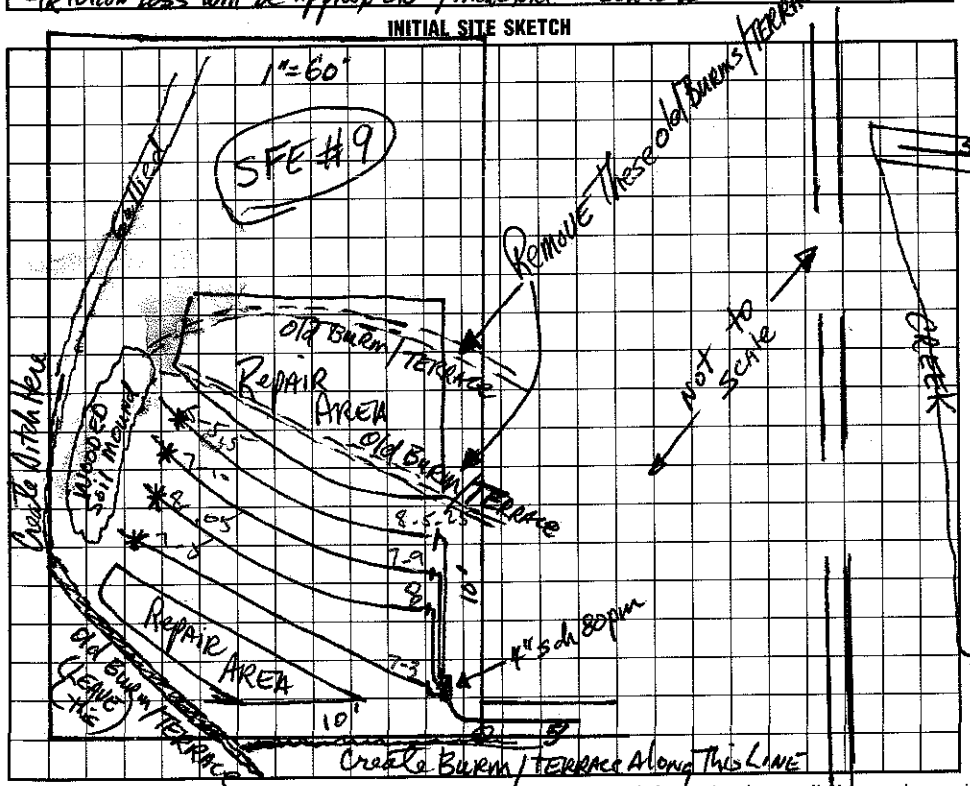

AS BUILT SKETCH

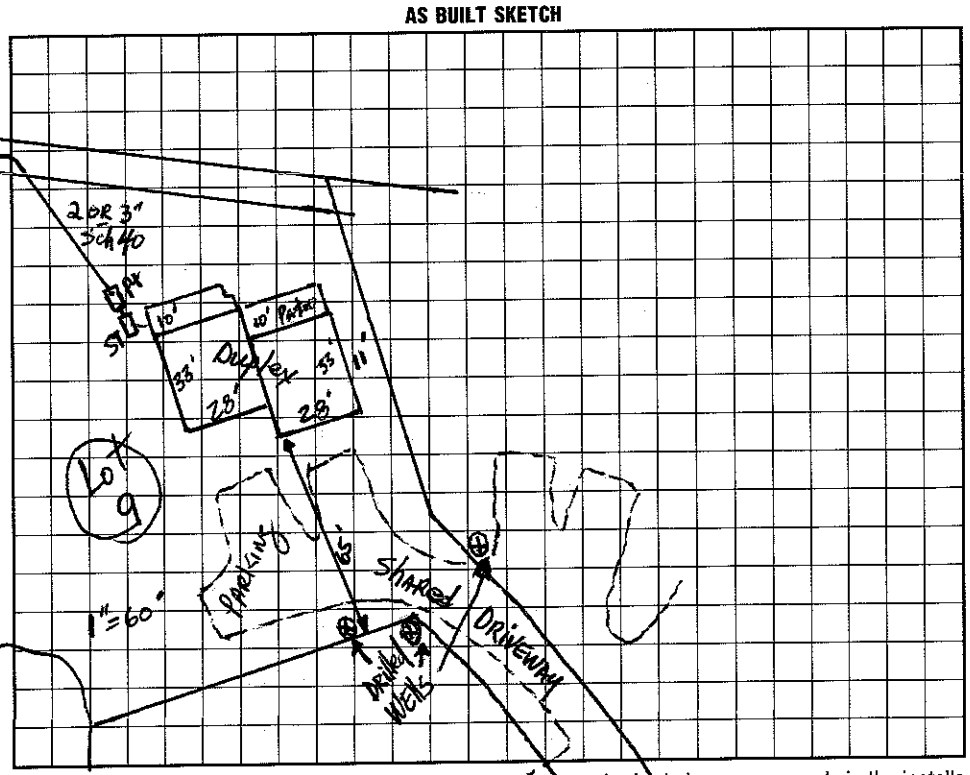

I understand that this permit can be suspended or revoked if any false information is supplied toward securing the permit/any unauthorized changes are made to the site/any unauthorized changes are made in the installation of the system. Improvement Permit with plat valid without expiration. Improvement Permit with site plan valid for sixty months. Authorization to Construct is valid for a period equal to that of Improvement Permit – not to exceed sixty months.

Signed: Bonanza Development Co. Inc by X Scott A. Beardsley date 2/20/98

Improvement Permit by: David R. Erwin RS date 2-20-98

Authorization to Construct by: David R. Erwin RS date 2-20-98

Installed by: FJ Erwin

Operation Permit by: Wesley Sparks RS date 11/8/99

Existing System Inspection by: date

HEALTH DEPT. COPY: WHITE INSPECTION COPY (FINAL): GREEN OWNER COPY (FINAL): YELLOW INSPECTION COPY (INITIAL): PINK OWNER COPY (INITIAL): GOLD

Turby-hill Road