IREDELL COUNTY HEALTH DEPARTMENT

STATESVILLE 704-878-5305 MOORESVILLE 704-664-5281

IMPROVEMENT PERMIT / CERTIFICATE OF COMPLETION / OPERATION PERMIT / EXISTING SYSTEM INSPECTION

PROPERTY DESCRIPTION NO. 21998 DATE May 17, '96 TAX MAP NO. part of 2K B45 Watershed: ☑ Yes ☐ No

OWNER OR CONTRACTOR Bonanza Dev. Co. PHONE: Business ~~Home~~ 4636-34-1152

ADDRESS PO Box 1156 Mooresville, NC

LOCATION Brawley Sch. Rd. TL Isle of Pines TL 12th Street (Double Eagle Dr.) at end

SUBDIVISION Mallard Pines BLOCK / SECTION III LOT 15 LOT AREA 30,000 ft² SITE CLASS. PS pre 1978 DESIGN FLOW 480 gpd L.T.A.R. = 3

Septic Tank: 1500 Gallons; STB ____ Date ____

Pump Tank: ____ Gallons; PT ____ Date ____

Pump Make: ____ Model ____ Serial No. ____

Nitrification Field: No. Fields 2 Square Feet 1200 Linear Feet 400

No. Lines 3+4 Trench Width 36" Max Trench Bottom Depth @ 24" Gravel Depth NA

☑ New System ☐ Repair System Type: I, II, (III), IV, V, VI

System Description: gravity chambered

Repair System Description: LD APPBB - off site EASEMENT

Maintenance Agreement Required: ☐ Yes ☑ No

☐ House/Mod. Home ☐ Mobile Home ☐ Business ☑ Other Duplex Apt.

No. Bedrooms 4 No. Bathrooms 4 No. Employees ____


☑ Slab ☐ Crawl Space ☐ Basement w/plumbing ☐ Basement wo/plumbing

Water Supply: ☑ Individual ☐ Community ☐ Public — off site


Comments:

Comments:

INITIAL SITE SKETCH

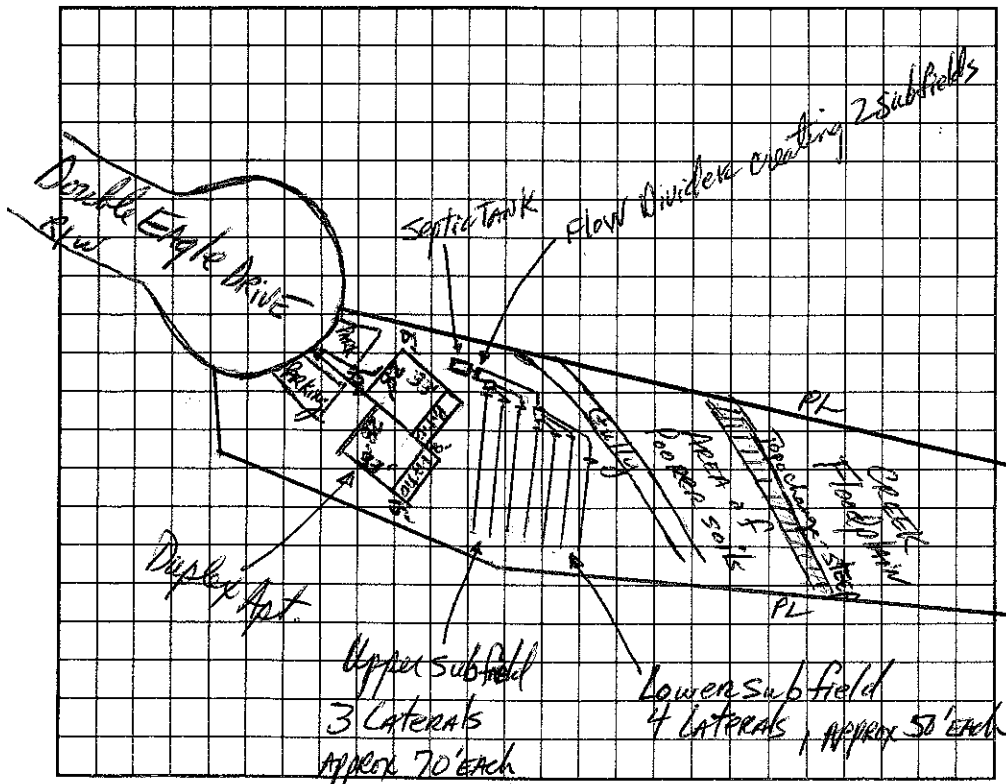

AS BUILT SKETCH

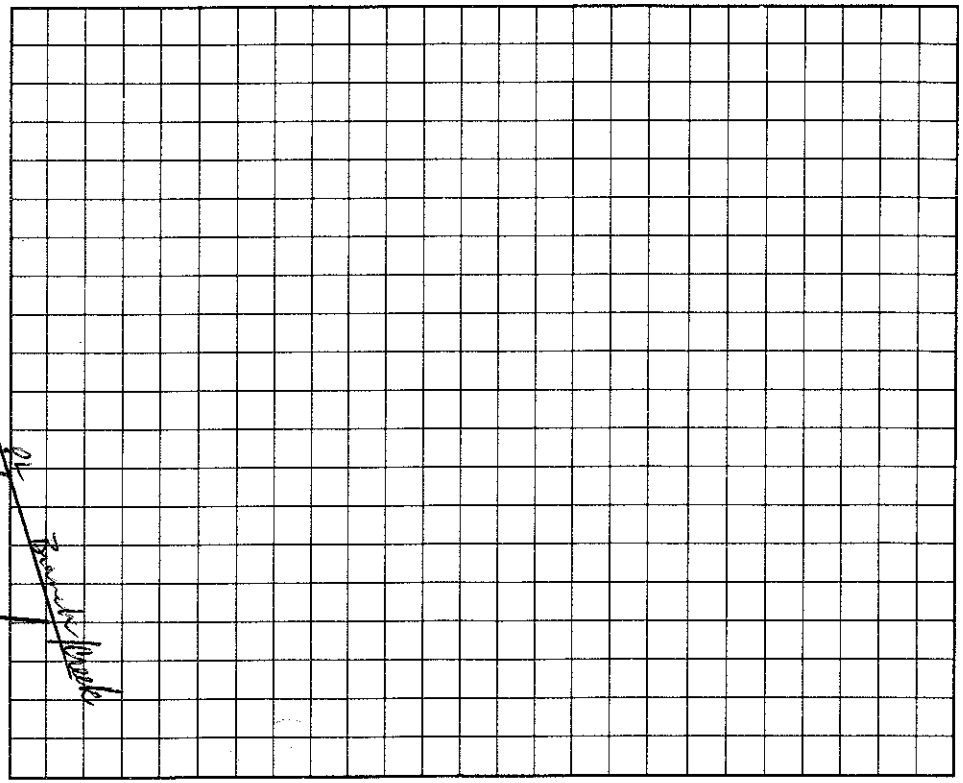

I understand that this permit can be suspended or revoked if any false information is supplied toward securing the permit/any unauthorized changes are made to the site/any unauthorized changes are made in the installation of the system.

Signed: Mark J. Reed

Improvement Permit by: Mark D. Hanson, RS date 5-17-96

~~Existing System Inspection by:~~ Construction Authorization by: Mark D. Hanson, RS date 8-27-96

Installed by: F.T. Ervin

Certificate of Completion by: Wesley Speaks RS. date 6/12/97

Operation Permit by: Wesley Speaks RS. date 6/12/97

HEALTH DEPT. COPY: WHITE INSPECTION COPY (FINAL): GREEN OWNER COPY (FINAL): YELLOW INSPECTION COPY (INITIAL): PINK OWNER COPY (INITIAL): GOLD