IREDELL COUNTY HEALTH DEPARTMENT

STATESVILLE 704-878-5305 MOORESVILLE 704-664-5281

IMPROVEMENT PERMIT / CERTIFICATE OF COMPLETION / OPERATION PERMIT / EXISTING SYSTEM INSPECTION

PROPERTY DESCRIPTION NO. 21997 DATE April 30, '96 TAX MAP NO. Pt of 2KB45 Watershed: ☑ Yes ☐ No

OWNER OR CONTRACTOR Bonanza Dev. Co. PHONE: Business ~~Home~~ 4634-34-1393

ADDRESS PO Box 1186 Mooresville

LOCATION Brawley Sch Rd. TL Clerk of Pines 1/4 mile TL Newstreet at end

SUBDIVISION Millard Pines BLOCK / SECTION Plan 3 LOT 14 LOT AREA 30,000 ft² SITE CLASS. Sp. 1956 DESIGN FLOW 480 gpd L.T.A.R. .03

Septic Tank: 1500 Gallons; STB 747 Date 9/20/17

Pump Tank: _____ Gallons; PT _____ Date _____

Pump Make: _____ Model _____ Serial No. _____

Nitrification Field: No Fields 2 Square Feet 1200 Linear Feet 400

No Lines 5+5 Trench Width 36" Max Trench Bottom Depth 36" Gravel Depth N/A

☑ New System ☐ Repair System Type: I, II, III, IV, V, VI

System Description: gravity chambered

Repair System Description: LPP PABPS - offsite easement

Maintenance Agreement Required: ☐ Yes ☑ No

☐ House/Mod. Home ☐ Mobile Home ☐ Business ☑ Other Duplex Apt.

No. Bedrooms 4/4 No. Bathrooms _____ No. Employees _____

☑ Slab ☐ Crawl Space ☐ Basement w/plumbing ☐ Basement wo/plumbing


Water Supply: ☑ Individual ☐ Community ☐ Public

Comments:

Comments:

1" = 100'

INITIAL SITE SKETCH

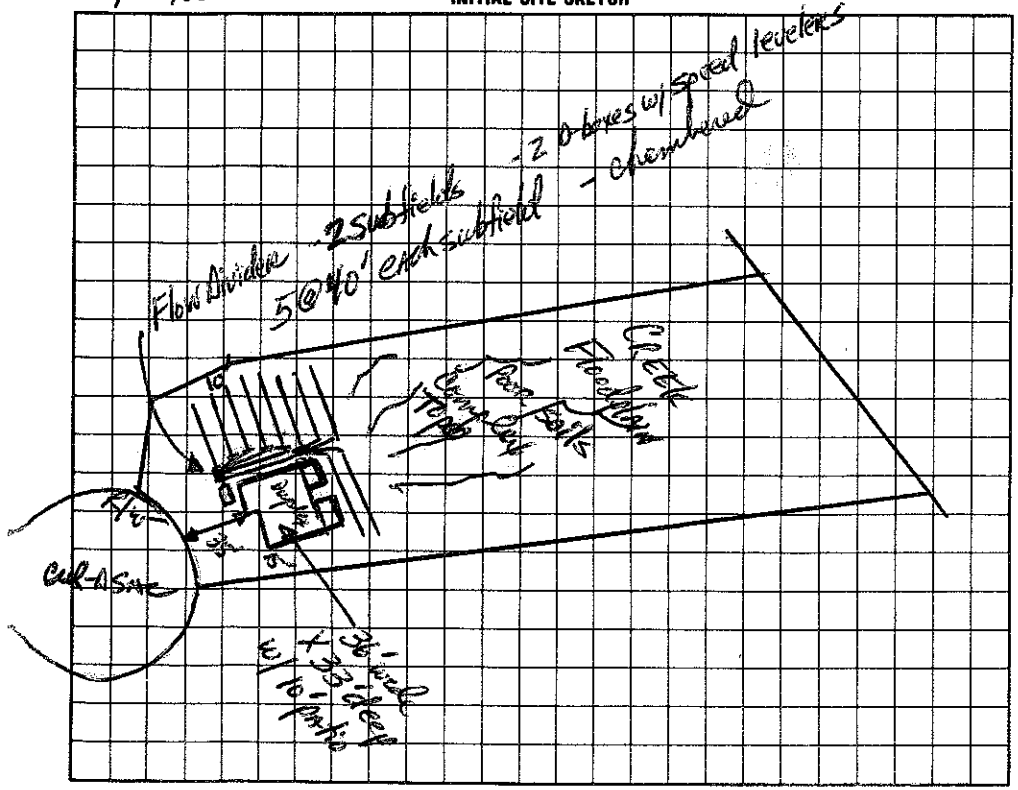

AS BUILT SKETCH

SAME AS SKETCH

I understand that this permit can be suspended or revoked if any false information is supplied toward securing the permit/any unauthorized changes are made to the site/any unauthorized changes are made in the installation of the system.

Signed: Mark Kroegell

Improvement Permit by: David Adams, RS date 4-30-96

Existing System Inspection by: Marvin R Jenson, RS date 8-28-96

Installed by: FJ ERVIN

Certificate of Completion by: _____ date _____

Operation Permit by: C. Berry Isenhour date 11/19/97

HEALTH DEPT. COPY: WHITE INSPECTION COPY (FINAL): GREEN OWNER COPY (FINAL): YELLOW INSPECTION COPY (INITIAL): PINK OWNER COPY (INITIAL): GOLD