124724

124724 Permit #

450. Fq. d

IREDELL COUNTY HEALTH DEPARTMENT

STATESVILLE 704-878-5305 MOORESVILLE 704-664-5281

IMPROVEMENT PERMIT / AUTHORIZATION TO CONSTRUCT / OPERATION PERMIT / EXISTING SYSTEM INSPECTION

PERMIT# ~~10825~~ PIN# 4636 34 4468 DATE 10/24/06

OWNER OR APPLICANT WM SKEEN PHONE Business 704 574 0747 Home

ADDRESS 259 PINTAIL LN. MOORESVILLE, NC 28117

LOCATION 1100 TL STATTS RD. TR FAIRWAY DR. ON L OFF CUL DE SAC

SUBDIVISION FAIRWAY ESTATE BLOCK / SECTION ____ LOT 225 LOT AREA 1.2 AC SITE CLASS A5 DESIGN FLOW 360 L.T.A.R. .17 (LPP)

Septic Tank: 1000 Gallons: STB 780 Date 4/16/08
Pump Tank: 1000 Gallons: PT 363 Date 2/13/08
Pump Make: ZOELLER Model N-152B Serial No. 1168
Nitrification Field: No Fields 1 Square Feet 2070 Linear Feet 414
No Lines 6@69 Trench Width 18 Max Trench Bottom Depth 12" Gravel Depth 12"

☒ New System ☐ Repair ☐ Expansion System Type: I II III IV V
System Description: LPP - TRUE
Repair System Description: SAME
Maintenance Agreement Required: ☒ Yes ☐ No
☐ Gravity ☐ Pressure ☐ Slab ☐ Crawl Space ☐ Basement w/plumbing ☐ Basement wo/plumbing

☒ House/Mod. Home No. Bedrooms 3
☐ Mobile Home No. Persons ____
☐ Business No. Employees ____
☐ Other

Water Supply: ☒ Individual ☐ Public ☐ Community


Comments:/Conditions:

(1) TRUE LPP SYSTEM DONT INSTALL WITHOUT R. WILLIAMS DESIGN SPECS.

(2) 30" DEEP FARM DRAIN REQUIRED 10' UPSLOPE OF LPP DRAINFIELD


(3) MAINTENANCE CONTRACT IS REQUIRED.

INITIAL SITE SKETCH

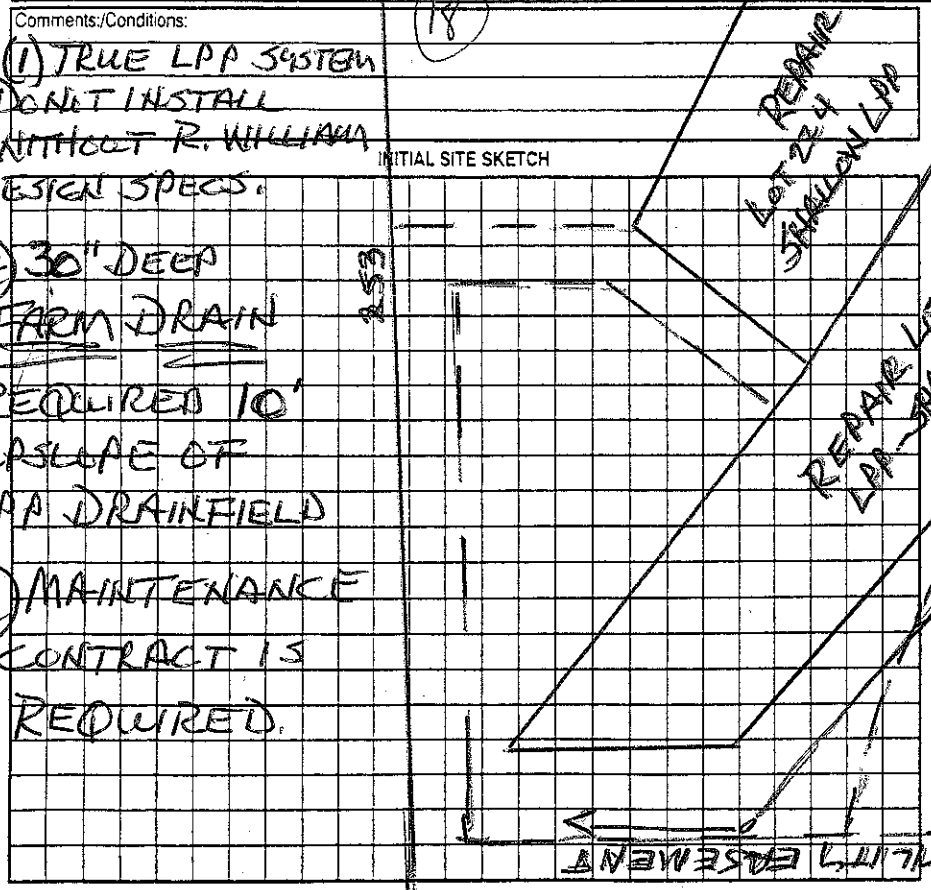

Comments:/Conditions:

AS-BUILT SKETCH

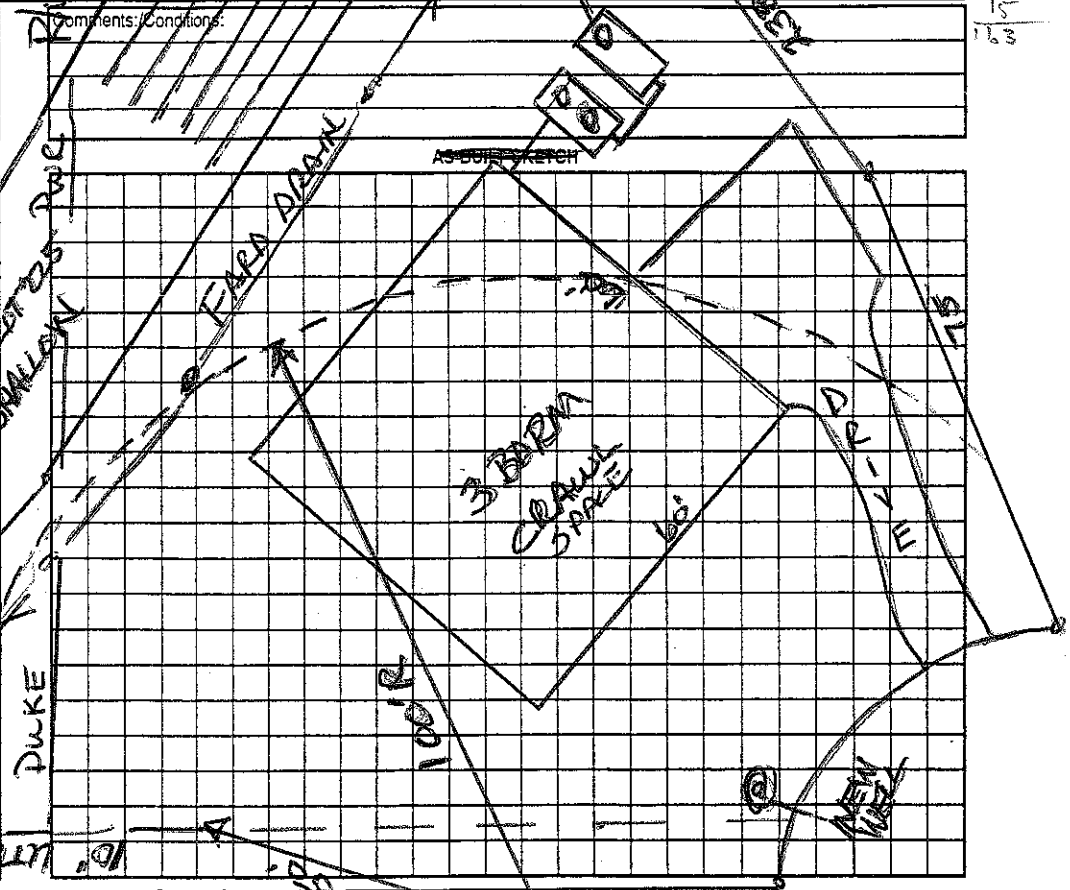

Permit can be suspended or revoked if any false information is supplied toward securing the permit/any unauthorized changes are made to the site/any unauthorized changes are made in the installation of the system. Improvement Permit with plat valid without expiration ☐ Improvement Permit with site plan valid for sixty months ☐ Authorization to Construct is valid for a period equal to that of Improvement Permit – not to exceed sixty months.

Signed: William M. Skeen date 10-30-06 Installed by: Specialty Septic - Jamie O'Donnell

Improvement Permit by: Wesley Sparks RS. date 10/24/06 Operation Permit by: Anthony Cline Jr. date 5/19/08

Authorization to Construct by: Wesley Sparks RS date 10/24/06 Existing System Inspection by: ____ date ____

HEALTH DEPT. COPY: WHITE OWNER COPY (FINAL): YELLOW OWNER COPY (INITIAL): PINK