IREDELL COUNTY HEALTH DEPARTMENT

STATESVILLE 704-878-5305 MOORESVILLE 704-664-5281

IMPROVEMENT PERMIT / AUTHORIZATION TO CONSTRUCT / OPERATION PERMIT / EXISTING SYSTEM INSPECTION

PERMIT# 12991 ~~[illegible]~~ PIN# 4636347379 4615 DATE 12/31/01

OWNER OR CONTRACTOR WILLIAM SHEEN / Scott Ward PHONE: Business 878-965-8264 Home

ADDRESS 3802 BURTON ST SHERRILLS FORD NC

LOCATION BRAWLEY SCHOOL - TL STATTS - TR FAIRWAY

SUBDIVISION FAIRWAY ESTATES BLOCK / SECTION LOT 226 LOT AREA 1.25 SITE CLASS. PS DESIGN FLOW 360GPD L.T.A.R. .3050/AA

Septic Tank: 1000 Gallons; STB 760 Date 12-13-06
Pump Tank: Gallons; PT Date
Pump Make: Model Serial No.
Nitrification Field: No Fields 1 Square Feet 400 Linear Feet 300
No Lines 4@75' Trench Width 36" Max Trench Bottom Depth 24" Gravel Depth

☑ New System ☐ Repair System Type: I, II, (III), IV, V, VI
System Description: GRAVITY 25% REDUCTION
Repair System Description: LPP
Maintenance Agreement Required: ☐ Yes ☑ No


☑ House/Mod. Home No. Bedrooms 3
☐ Mobile Home No. Bathrooms 3
☐ Business No. Employees
☐ Other
☐ Slab ~~☑ Crawl Space~~ ☐ Basement w/plumbing ☐ Basement wo/plumbing

Water Supply: ☑ Individual ☐ Public ☐ Community


Comments:/Conditions: New Tank location = 10Ft from Daylight side of basement
Pool @ least 15' from any part of system

Comments:/Conditions:

INITIAL SITE SKETCH 1"=50'

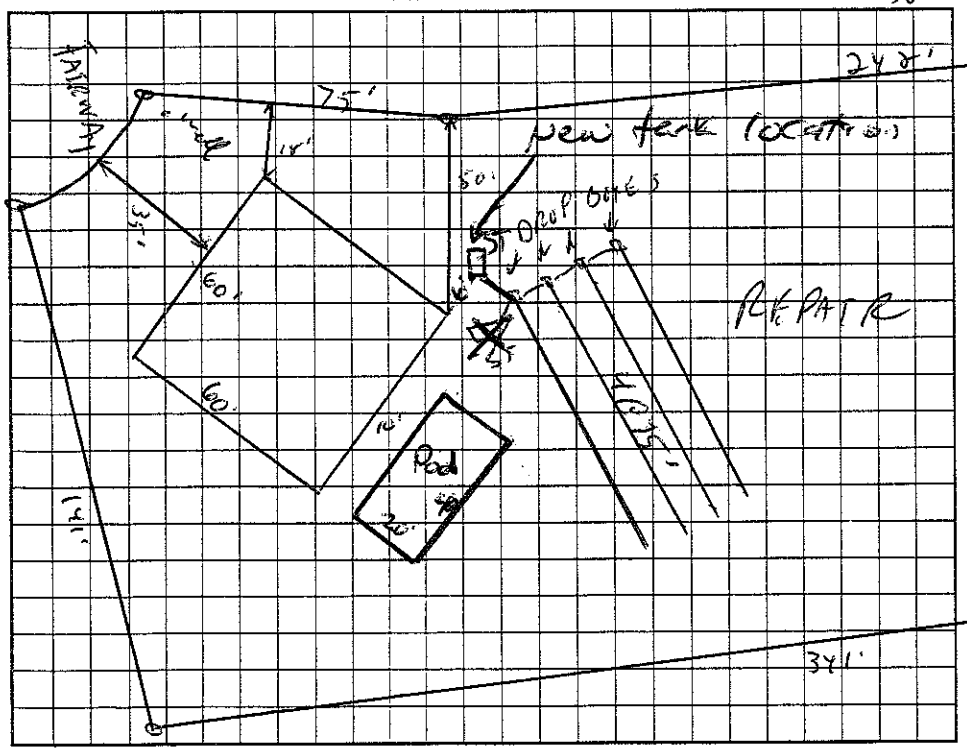

AS BUILT SKETCH

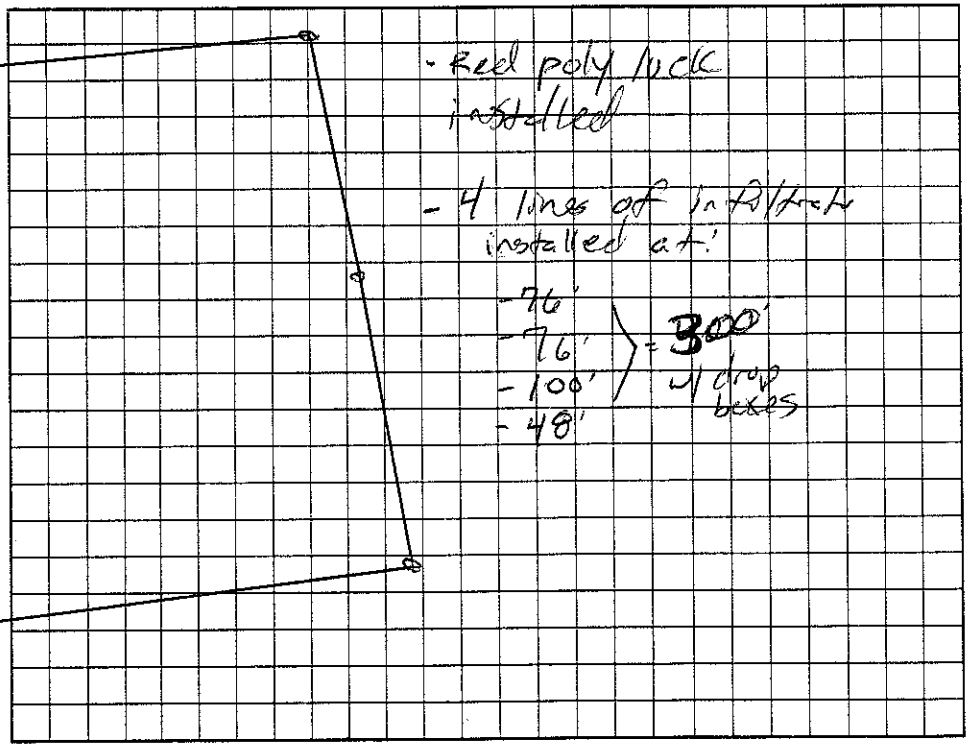

Permit can be suspended or revoked if any false information is supplied toward securing the permit/any unauthorized changes are made to the site/any unauthorized changes are made in the installation of the system. Improvement Permit with plat valid without expiration. Improvement Permit with site plan valid for sixty months. Authorization to Construct is valid for a period equal to that of Improvement Permit – not to exceed sixty months.

Signed: date

Improvement Permit by: date 12/31/01

Authorization to Construct by: date 10/2/06

Installed by: Leathersman Grading

Operation Permit by: date 3/26/07

Existing System Inspection by: date

HEALTH DEPT. COPY: WHITE OWNER COPY (FINAL): YELLOW OWNER COPY (INITIAL): PINK