IREDELL COUNTY HEALTH DEPARTMENT

STATESVILLE 704-878-5305 MOORESVILLE 704-664-5281

IMPROVEMENT PERMIT / AUTHORIZATION ~~TO~~ CONSTRUCT / OPERATION PERMIT / EXISTING SYSTEM INSPECTION

PERMIT# 1291 ~~[illegible]~~ PIN# 4636348379 DATE 12/31/01

OWNER OR CONTRACTOR WILLIAM SHEAN / Scott Ward PHONE: Business 828-465-8268 Home

ADDRESS 3402 BURTON ST SHERRILLS FORD NC

LOCATION BRAWLEY SCHOOL - TL STUTTS - TR FAIRWAY

SUBDIVISION FAIRWAY ESTATES BLOCK / SECTION LOT 226 LOT AREA 1.25 SITE CLASS. AS DESIGN FLOW 360GPD L.T.A.R. .3050/EP

Septic Tank: 1000 Gallons; STB 160 Date 12-13-06

Pump Tank: Gallons; PT Date

Pump Make: Model Serial No.

Nitrification Field: No Fields 1 Square Feet 400 Linear Feet 300

No Lines 4@75' Trench Width 36" Max Trench Bottom Depth 24" Gravel Depth

☑ New System ☐ Repair System Type: I, II, (III), IV, V, VI

System Description: GRAVITY 25% REDUCTION

Repair System Description: LPP

Maintenance Agreement Required: ☐ Yes ☑ No

☑ House/Mod. Home No. Bedrooms 3

☐ Mobile Home No. Bathrooms 3

☐ Business No. Employees

☐ Other

☐ Slab ~~☑ Crawl Space~~ ☐ Basement w/plumbing ☐ Basement wo/plumbing


Water Supply: ☑ Individual ☐ Public ☐ Community

Comments:/Conditions: New Tank location = 10 ft from Daylight side of basement


Pool @ least 15' from any part of system

Comments:/Conditions:

INITIAL SITE SKETCH 1"=50'

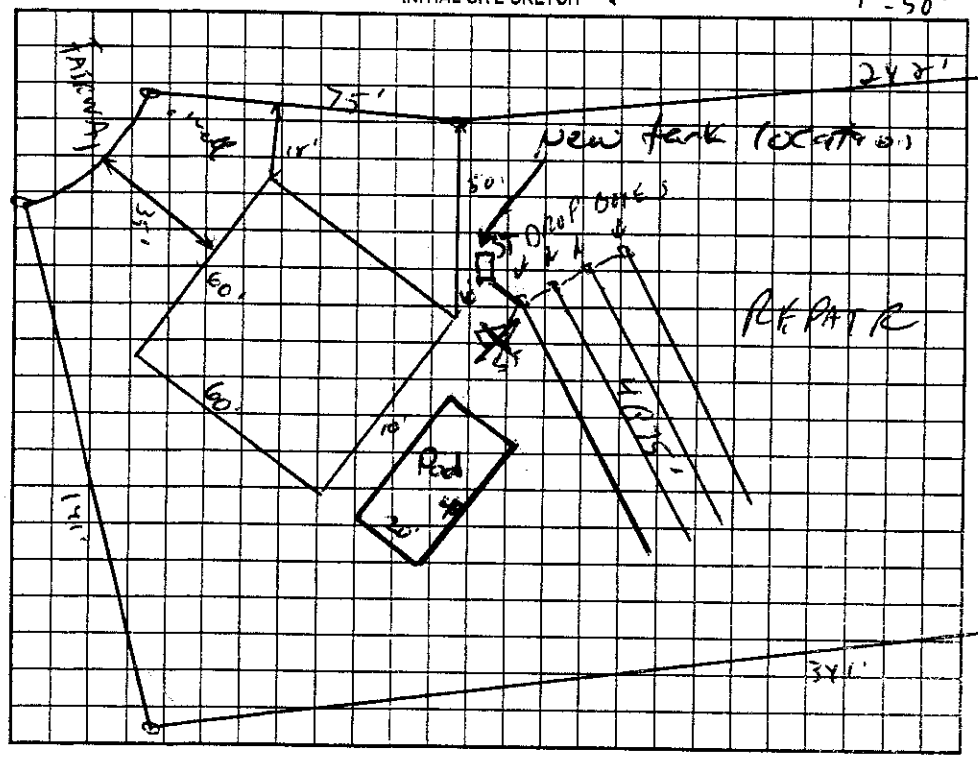

AS BUILT SKETCH

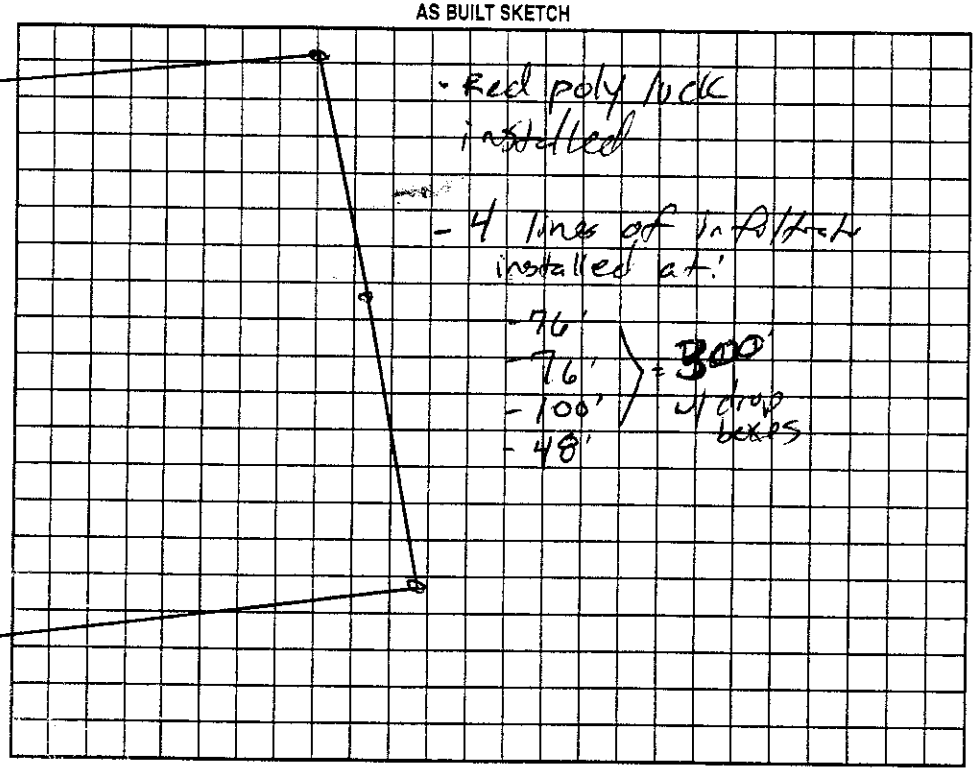

Permit can be suspended or revoked if any false information is supplied toward securing the permit/any unauthorized changes are made to the site/any unauthorized changes are made in the installation of the system. Improvement Permit with plat valid without expiration. Improvement Permit with site plan valid for sixty months. Authorization to Construct is valid for a period equal to that of Improvement Permit – not to exceed sixty months.

Signed: date Installed by: Leathermen Grading

Improvement Permit by: C. [illegible] REHS date 12/31/01 Operation Permit by: Josh E Alt date 3/26/07

Authorization to Construct by: Josh E Alt date 10/2/06 Existing System Inspection by: date

HEALTH DEPT. COPY: WHITE OWNER COPY (FINAL): YELLOW OWNER COPY (INITIAL): PINK