IREDELL COUNTY HEALTH DEPARTMENT

Auth. expiration to Construct

STATESVILLE 704-878-5305 MOORESVILLE 704-664-5281

IMPROVEMENT PERMIT / ~~CERTIFICATE OF COMPLETION~~ / OPERATION PERMIT / EXISTING SYSTEM INSPECTION

PROPERTY DESCRIPTION NO. 26183 DATE 3/14/97 TAX MAP NO. 4636349385 7471 Watershed: X Yes ☐ No

OWNER OR CONTRACTOR Richard Bond PHONE: Business _____ Home 662-3009

ADDRESS 535-108 Shearers Rd. Mooresville, NC. 28115

LOCATION Brawley Sch. TL Stubbs Rd. TR Fairway Dr., on (L) two back from cul de sac

SUBDIVISION Fairway Est. BLOCK / SECTION _____ LOT 223 LOT AREA .58 SITE CLASS PS DESIGN FLOW 360 L.T.A.R. .3

Septic Tank: 1000 Gallons; STB 825 Date 5/19/97

Pump Tank: _____ Gallons; PT _____ Date _____

Pump Make: _____ Model _____ Serial No. _____

Nitrification Field: No Fields 1 Square Feet 1200 Linear Feet 400

No Lines 5 Trench Width 36" Max Trench Bottom Depth 36" Gravel Depth 12"

X New System ☐ Repair System Type: I, II, III, IV, V, VI

System Description: DIST BOX - CONVENTIONAL

Repair System Description: ~~STONE~~ APBS

Maintenance Agreement Required: ☐ Yes X No

☐ House/Mod. Home ☐ Mobile Home ☐ Business ☐ Other

No. Bedrooms 3 No. Bathrooms 2 No. Employees _____


☐ Slab X Crawl Space ☐ Basement w/plumbing ☐ Basement wo/plumbing

Water Supply: X Individual ☐ Community ☐ Public


Comments:

Comments: Due to growing trees - Repair must be 16" APBS - No variance was given to IC HO about trees - AWS

INITIAL SITE SKETCH

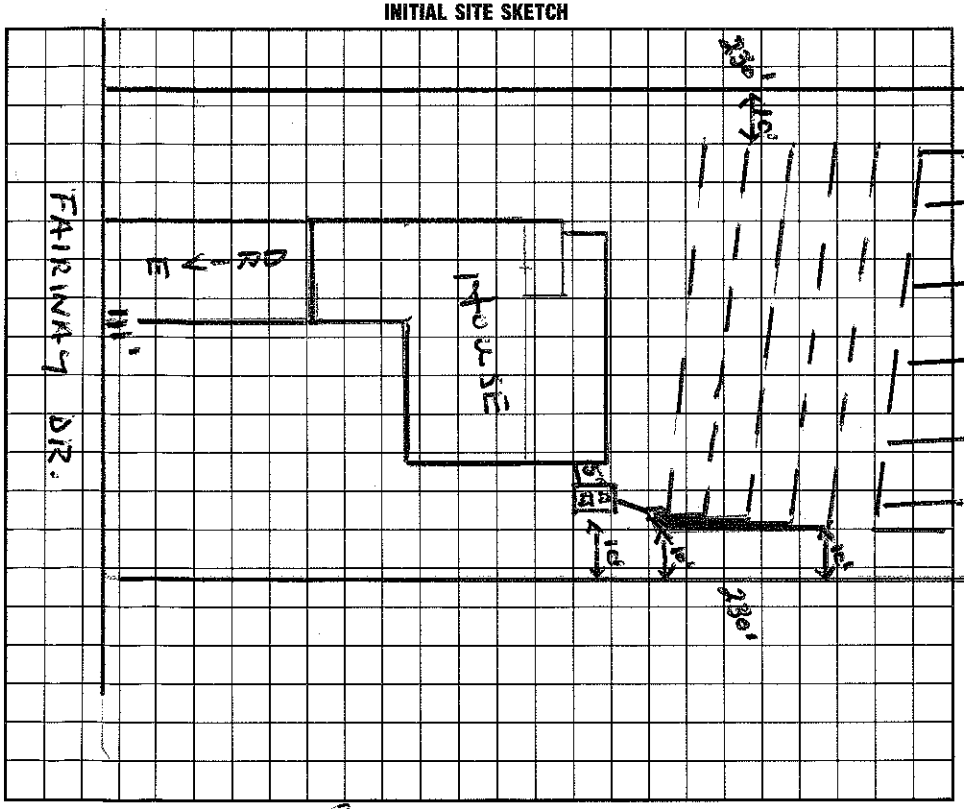

AS BUILT SKETCH

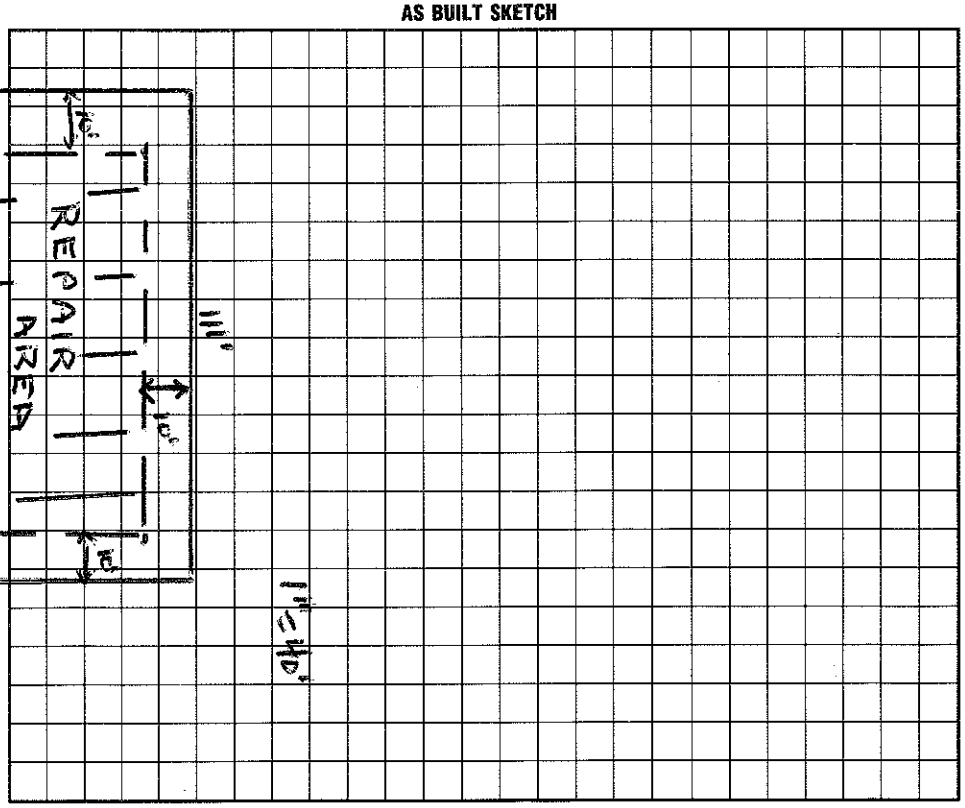

I understand that this permit can be suspended or revoked if any false information is supplied toward securing the permit/any unauthorized changes are made to the site/any unauthorized changes are made in the installation of the system. Improvement Permit is valid for 60 months from date of issuance.

Signed: * [signature]

Improvement Permit by: Wesley Sparks R.S. date 3/14/97

Existing System Inspection by: Wesley Sparks R.S. date 3/14/97

Installed by: Delbert Boston

Certificate of Completion by: Wesley Sparks R.S. date 8/21/97

Operation Permit by: Wesley Sparks R.S. date 8/21/97

HEALTH DEPT. COPY: WHITE INSPECTION COPY (FINAL): GREEN OWNER COPY (FINAL): YELLOW INSPECTION COPY (INITIAL): PINK OWNER COPY (INITIAL): GOLD